

Revised

WATER WELL RECORD

Form WWC-5


Division of Water Resources App. No.

Well ID MW10

Original Record Correction Change in Well Use

1 LOCATION OF WATER WELL: County Shawnee Fraction NW 1/4 SW 1/4 NW 1/4 NW 1/4 Section Number 19 Township Number T 12 S Range Number R 16 E W

2 WELL OWNER: Last Name: Business: Ed Bozarth Chevrolet, Inc. Address: 3731 SW Topeka Blvd City Topeka State: KS ZIP: Street or Rural Address where well is located (if unknown, distance and direction from nearest town or intersection): 3736 SW Topeka Blvd., Topeka KS

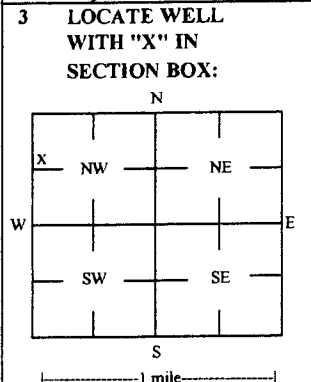

3 LOCATE WELL WITH 'X' IN SECTION BOX: 4 DEPTH OF COMPLETED WELL: 17.5 ft Depth(s) Groundwater Encountered: 1) 17.5 ft 2) 0 ft or 4) Dry Well WELL'S STATIC WATER LEVEL: 10.65 ft

5 Latitude: 38.99882 (decimal degrees) Longitude: 95.68688 (decimal degrees) Horizontal Datum: X WGS 84 NAD 83 NAD 27 Source for Latitude/Longitude: X Land Survey Topographic Map Online Mapper

6 Elevation 1003.06 ft Ground Level X TOC Source: X Land Survey GPS Topographic Map Other

7 WELL WATER TO BE USED AS: 1 Domestic: Household Lawn & Garden Livestock Irrigation Feedlot Industrial 5 Public Water Supply: well ID 6 Dewatering: how many wells? 7 Aquifer Recharge: well ID 8 X Monitoring: well ID MW10 9 Environmental Remediation: well ID Air Sparge Soil Vapor Extractor Recovery Injection 10 Oil Field Water Supply: lease 11 Test Hole: well ID Cased Uncased Geotechnical 12 Geothermal: How many bores? a) Closed Loop Horizontal Vertical b) Open Loop Surface Discharge Inj. of Water Other (specify):

Was a chemical/bacteriological sample submitted to KDHE? Yes No X No If yes, date sample was submitted: Water well disinfected? Yes No X No

8 TYPE OF CASING USED: Steel PVC Other CASING JOINTS: Glued Clamped Welded X Threaded Casing diameter 2 in. to 7.5 ft Diameter in. to ft Diameter in. to ft Casing height above land surface 2.10 in. Weight lbs./ft. Well thickness or gauge No TYPE OF SCREEN OR PERFORATION MATERIAL: Steel Stainless Steel Fiberglass PVC Other (Specify) Brass Galvanized Steel Concrete tile None used (open hole) SCREEN OR PERFORATION OPENINGS ARE: Continuous Slot X Mill Slot Gauze Wrapped Torch Cut Drilled Holes Other (Specify) Louvered Shutter Key Punched Wire Wrapped Saw Cut None (Open Hole) SCREEN-PERFORATED INTERVALS: From 7.5 ft. to 17.5 ft. From ft. to ft. From ft. to ft. GRAVEL PACK INTERVALS: From 3 ft. to 15 ft. From ft. to ft. From ft. to ft.

9 GROUT MATERIAL: Neat cement Cement grout X Bentonite X Other Concrete: 0-0.5' Grout intervals: From 0.5 ft. to 3 ft. From ft. to ft. From ft. to ft.

Nearest source of possible contamination: Septic Tank Lateral Lines Pit Privy Livestock Pens Insecticide Storage Sewer Lines Cess Pool Sewage Lagoon X Fuel Storage Abandoned Water Well Watertight Sewer Lines Seepage Pit Feedyard Fertilizer Storage Oil Well / Gas Well Other (Specify):

Direction from well? SW Distance from well? ~420 ft

Table with columns: 10 FROM, TO, LITHOLOGIC LOG, FROM, TO, LITHO. LOG (cont.) or PLUGGING INTERVALS. Rows: 0 to 0.5 (Grass & topsoil), 0.5 to 6 (Silty clay), 6 to 15 (Shale, trace clay).

Notes: KDHE ID: Ed Bozarth Chevrolet, Inc.; U4-089-01163 Target of monitoring well is shallow groundwater, <20' of grout was installed at the direction of KDHE.

11 CONTRACTOR'S OR LANDOWNER'S CERTIFICATION: This water well was X constructed, reconstructed, or plugged under my jurisdiction and was completed on (mo-day-year) 5/8/17 and this record is true to the best of my knowledge and belief. Kansas Water Well Contractor's License No 757 This Water Well Record was completed on (mo-day-year) 5/23/17 under the business name of Larsen & Associates, Inc. Signature

WATER WELL RECORD

Form WWC-5

Division of Water Resources App. No.

Well ID

MW10

X Original Record Correction Change in Well Ust

1 LOCATION OF WATER WELL: County Shawnee Fraction NW SW NE E Section Number 19 Township Number T 12 S Range Number R 15 E W
2 WELL OWNER: Last Name: Business: Ed Bozarth Chevrolet, Inc. Address: 3731 SW Topeka Blvd City Topeka State: KS ZIP:
3 LOCATE WELL WITH "X" IN SECTION BOX:
4 DEPTH OF COMPLETED WELL: 17.5 ft Depth(s) Groundwater Encountered: 1) 17.5 ft 2) Dry Well WELL'S STATIC WATER LEVEL: 10.65 ft.
5 Latitude: 38.99882 (decimal degrees) Longitude: 95.68688 (decimal degrees) Horizontal Datum: X WGS 84 NAD 83 NAD 27
6 Elevation 1003.06 ft Ground Level TOC Source X Land Survey GPS Topographic Map

7 WELL WATER TO BE USED AS:
1 Domestic: Household Lawn & Garden Livestock Irrigation Feedlot Industrial
2 Public Water Supply: well ID
3 Dewatering: how many wells?
4 Aquifer Recharge: well ID
5 Monitoring: well ID MW10
6 Environmental Remediation: well ID
7 Air Sparge Soil Vapor Extractor
8 Recovery Injection
9 Oil Field Water Supply: lease
10 Test Hole: well ID
11 Cased Uncased Geotechnical
12 Geothermal: How many bores?
a) Closed Loop Horizontal Vertical
b) Open Loop Surface Discharge Inj. of Water
Other (specify):

Was a chemical/bacteriological sample submitted to KDHE? Yes No X No
If yes, date sample was submitted:
Water well disinfected? Yes No X No

8 TYPE OF CASING USED: Steel PVC X Other CASING JOINTS: Glued Clamped Welded X Threaded
Casing diameter 2 in. to 7.5 ft. Diameter in. to ft. Diameter in. to ft.
Casing height above land surface 2.10 in. Weight lbs./ft. Well thickness or gauge No
TYPE OF SCREEN OR PERFORATION MATERIAL: Steel Stainless Steel Fiberglass PVC X Other (Specify)
SCREEN OR PERFORATION OPENINGS ARE: Continuous Slot X Mill Slot Gauze Wrapped Torch Cut Drilled Holes Other (Specify)
SCREEN-PERFORATED INTERVALS: From 7.5 ft. to 17.5 ft. From ft. to ft. From ft. to ft.
GRAVEL PACK INTERVALS: From 3 ft. to 15 ft. From ft. to ft. From ft. to ft.

9 GROUT MATERIAL: Neat cement Cement grout Bentonite X Other Concrete: 0-0.5'
Grout intervals: From 0.5 ft. to 3 ft. From ft. to ft. From ft. to ft.

Nearest source of possible contamination:
Septic Tank Lateral Lines Pit Privy Livestock Pens Insecticide Storage
Sewer Lines Cess Pool Sewage Lagoon X Fuel Storage Abandoned Water Well
Watertight Sewer Lines Seepage Pit Feedyard Fertilizer Storage Oil Well / Gas Well
Other (Specify)
Direction from well? SW Distance from well? ~420 ft

Table with 6 columns: FROM, TO, LITHOLOGIC LOG, FROM, TO, LITHO. LOG (cont.) or PLUGGING INTERVALS
0 0.5 Grass & topsoil
0.5 6 Silty clay
6 15 Shale, trace clay

Notes: KDHE ID: Ed Bozarth Chevrolet, Inc.; U4-089-01163 Target of monitoring well is shallow groundwater, <20' of grout was installed at the direction of KDHE.

11 CONTRACTOR'S OR LANDOWNER'S CERTIFICATION: This water well was X constructed, reconstructed, or plugged under my jurisdiction and was completed on (mo-day-year) 5/8/17 and this record is true to the best of my knowledge and belief. Kansas Water Well Contractor's License No. 757 This Water Well Record was completed on (mo-day-year) 5/23/17 under the business name of Larsen & Associates, Inc. Signature