


WATER WELL PLUGGING RECORD Form WWC-5P KSA 82a-1212 ID NO.

1 **LOCATION OF WATER WELL:** Fraction 1/4 SE 1/4 SE 1/4 SE 1/4 Section Number 5 Township Number T 12 S Range Number 116 E W
 County: Shawnee

Street/Rural Address of Well Location; if unknown, distance & direction from nearest town or intersection: If at owner's address, check here SE 21st St. and SE California Ave. Topeka KS
 Global Positioning Systems (GPS) information:
 Latitude: 39.03033 (in decimal degrees)
 Longitude: 95.6515 (in decimal degrees)
 Elevation: _____
 Horizontal Datum: WGS84, NAD83, NAD27
 Collection Method: _____

2 **WATER WELL OWNER:** Chevron Env. Mgt. Co.
 RR#, St. Address, Box #: 4800 Fournance Road
 City, State ZIP Code: Bellaire TX 77401
 GPS unit (Make/Model: Garmin etrex)
 Digital Map/Photo, Topographic Map, Land Survey
 Est. Accuracy: <3 m, 3-5 m, 5-15 m, >15 m

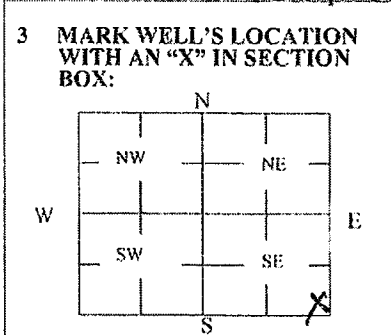

4 **DEPTH OF WELL** 19.25 ft.
 WELL'S STATIC WATER LEVEL _____ ft. MW-3
 WELL WAS USED AS:
 Domestic Public Water Supply Dewatering
 Irrigation Oil Field Water Supply Monitoring
 Feedlot Domestic (Lawn & Garden) Injection Well
 Industrial Air Conditioning
 Was a chemical/bacteriological sample submitted to Department? Yes No

5 **TYPE OF BLANK CASING USED:**
 Steel RMP (SR) Wrought Fiberglass Other (Specify below)
 PVC ABS Asbestos-Cement Concrete Tile
 Blank casing diameter 2 in. Was casing pulled? Yes No If yes, how much all
 Casing height above or below land surface -6 in.

6 **GROUT PLUG MATERIAL:** Neat cement Cement grout Bentonite Other Concrete
 Grout Plug Intervals: From 0 ft. to 3 ft., From 3 ft. to 19.25 ft., From _____ ft. to _____ ft.

What is the nearest source of possible contamination:
 Septic tank Seepage pit Fuel storage Other (specify below) Tire shop
 Sewer lines Pit privy Fertilizer storage
 Watertight sewer lines Sewage lagoon Insecticide storage
 Lateral lines Feedyard Abandoned water well Direction from well? E
 Cess pool Livestock pens Oil well/Gas well How many feet? #200 ft.

| FROM | TO | PLUGGING MATERIALS | FROM | TO | PLUGGING MATERIALS |
|------|-------|--------------------|------|----|--------------------|
| 0 | 3 | Concrete | | | |
| 3 | 19.25 | Bentonite | | | |
| | | | | | |
| | | | | | |

7 **CONTRACTOR'S OR LANDOWNER'S CERTIFICATION:** This water well was plugged under my jurisdiction and was completed on (mo/day/year) 5/5/17 and this record is true to the best of my knowledge and belief. Kansas Water Well Contractor's License No. 710. This Water Well Record was completed on (mo/day/year) 5/8/17 under the business name of Below Ground Surface, Inc. by (signature) Craig R. Hawn