

1 LOCATION OF WATER WELL: Fraction 1/4 SW 1/4 NW 1/4 NW 1/4 Section Number 19 Township Number T 12 S Range Number 16 [X] E [] W

Street/Rural Address of Well Location; if unknown, distance & direction from nearest town or intersection: If at owner's address, check here [X] 3740 S. Topeka Blvd Topeka, KS 66600 Global Positioning Systems (GPS) information: Latitude: (in decimal degrees) Longitude: (in decimal degrees) Elevation: 1008.46 Horizontal Datum: [] WGS84, [] NAD83, [X] NAD27 Collection Method:

2 WATER WELL OWNER: Tommy McGeeny RR#, St. Address, Box #: City, State ZIP Code: Est. Accuracy: [] < 3 m, [] 3-5 m, [X] 5-15 m, [] > 15 m

3 MARK WELL'S LOCATION WITH AN "X" IN SECTION BOX: [Diagram showing a 3x3 grid with an 'X' in the NW quadrant] 4 DEPTH OF WELL 23.89 ft. WELL'S STATIC WATER LEVEL 12.56 ft. WELL WAS USED AS: [] Domestic [] Irrigation [] Feedlot [] Industrial [] Public Water Supply [] Oil Field Water Supply [] Domestic (Lawn & Garden) [] Air Conditioning [] Dewatering [X] Monitoring [] Injection Well [] Other Was a chemical/bacteriological sample submitted to Department? Yes [] No [X]


5 TYPE OF BLANK CASING USED: [] Steel [X] PVC [] RMP (SR) [] ABS [] Wrought [] Asbestos-Cement [] Fiberglass [] Concrete Tile [] Other (Specify below) Blank casing diameter 2 in. Was casing pulled? Yes [X] No [] If yes, how much 3 FT Casing height above or below land surface 36 in.

6 GROUT PLUG MATERIAL: [] Neat cement [] Cement grout [X] Bentonite [] Other Grout Plug Intervals: From 23.89 ft. to 3 ft., From ft. to ft., From ft. to ft.

What is the nearest source of possible contamination: [] Septic tank [] Sewer lines [] Watertight sewer lines [] Lateral lines [] Cess pool [] Seepage pit [] Pit privy [] Sewage lagoon [] Feedyard [] Livestock pens [] Fuel storage [] Fertilizer storage [] Insecticide storage [] Abandoned water well [] Oil well/Gas well [X] Other (specify below) Ed Bozarth trust fund site Direction from well? West/NW How many feet? 350

FROM	TO	PLUGGING MATERIALS	FROM	TO	PLUGGING MATERIALS
0	3	Compact silt/clay			
3	23.89	Hydrated Bentonite chips			

7 CONTRACTOR'S OR LANDOWNER'S CERTIFICATION: This water well was plugged under my jurisdiction and was completed on (mo/day/year) 6/15/2017 and this record is true to the best of my knowledge and belief. Kansas Water Well Contractor's License No. 585. This Water Well Record was completed on (mo/day/year) 6/28/2017 under the business name of Associated Environmental, Inc. by (signature) [Signature]

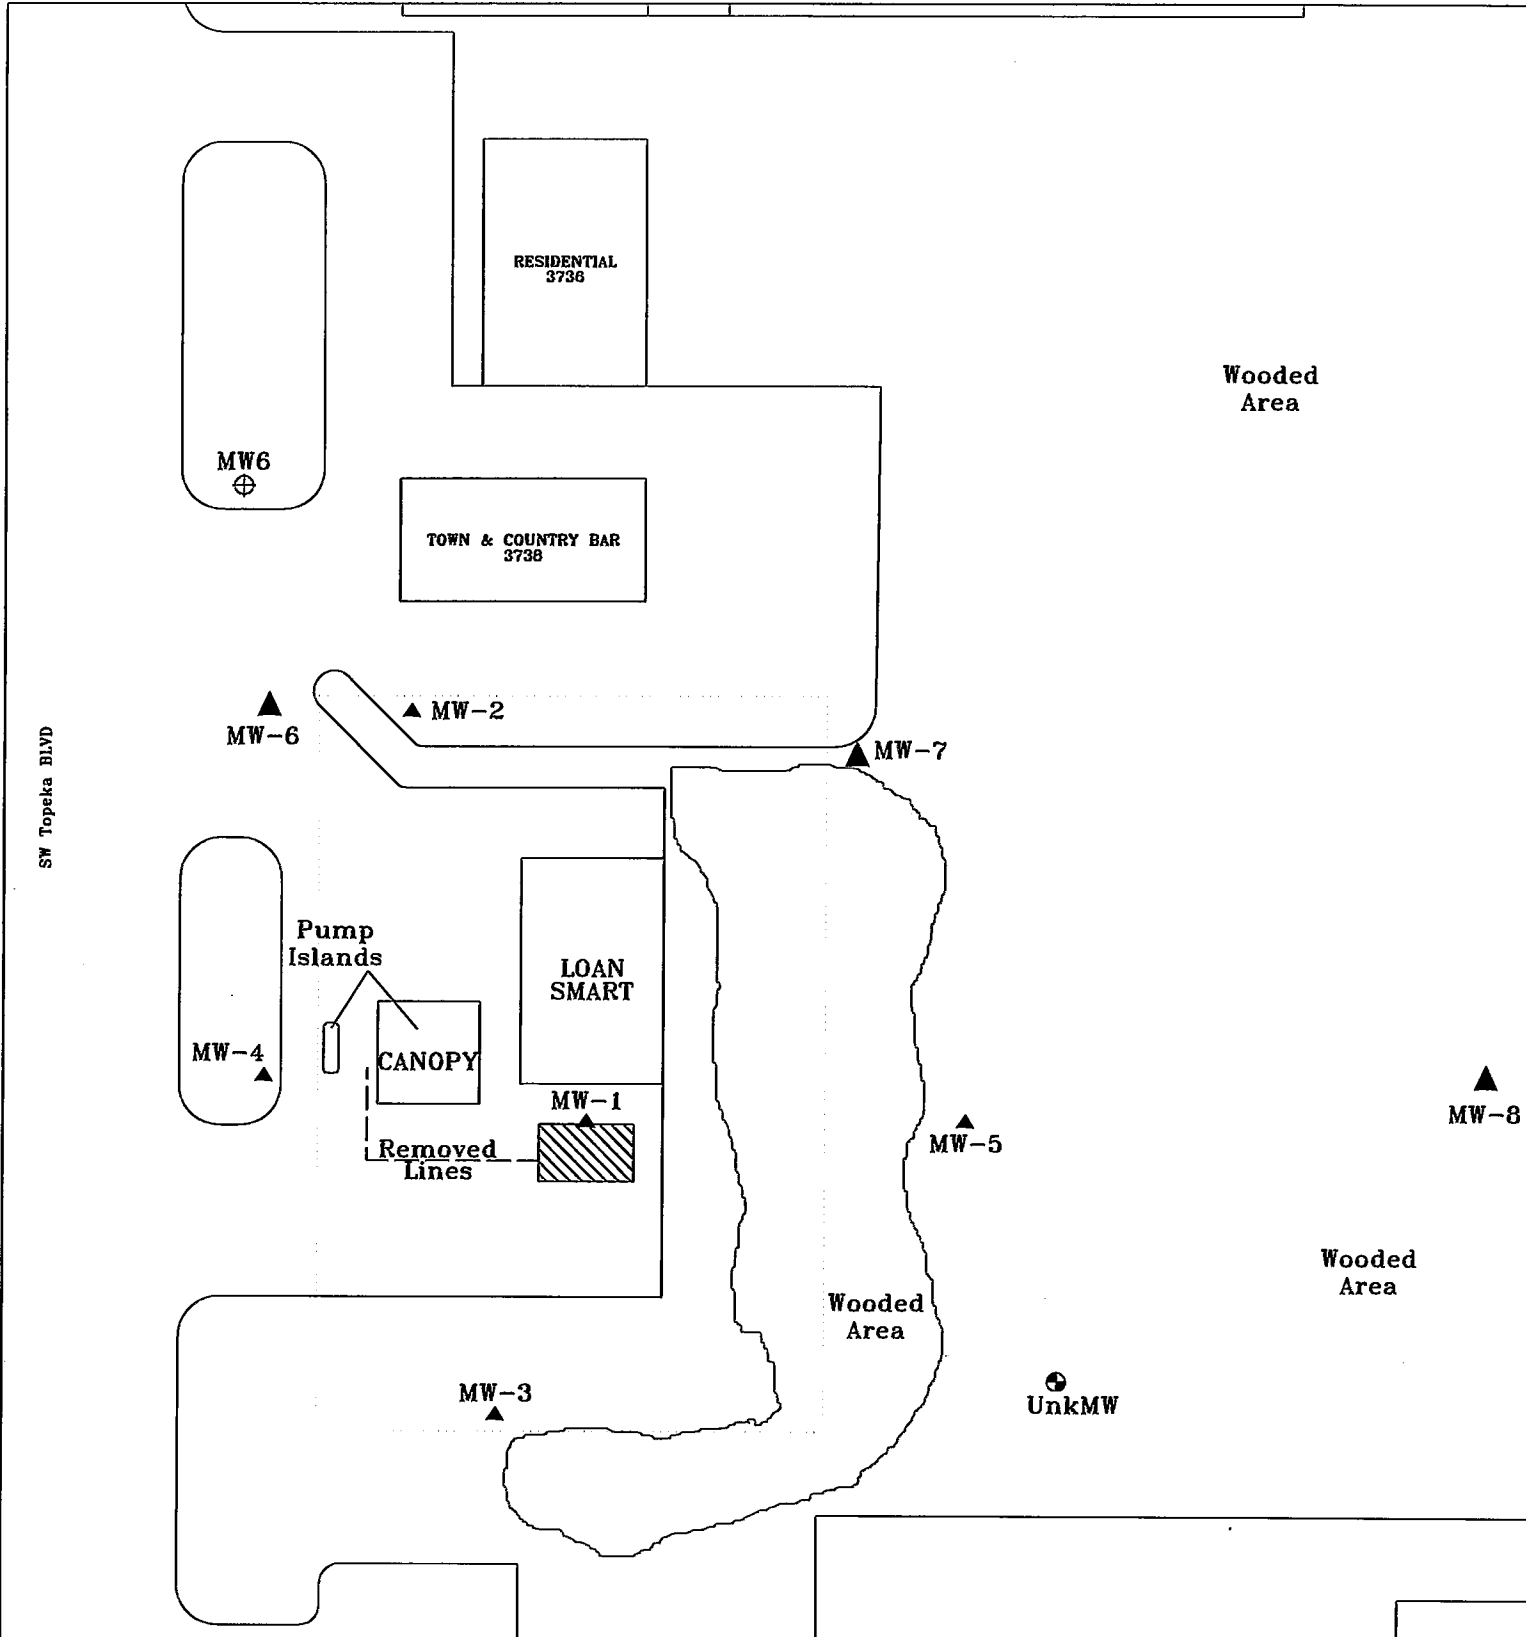

PROJECT: Fina Station-McGreeney Motors
 ADDRESS: 3740 SW Topeka Blvd
 LOCATION: Topeka, Kansas
 DRAWN BY: B. Scott DATE: 05/06/10
 REVISED BY: C. Roe DATE: 5/6/2010
 AEI JOB #: TF409 KDHE JOB #: U4-089-01388
 SCALE: 1" = 50'
 0 25 50

TITLE: Site Map
 ASSOCIATED ENVIRONMENTAL INC.
 NOTES: * = Site Benchmark undefined.
 Monitor wells MW-6, MW-7 & MW-8 plugged in 2001

LEGEND:
 = (3) Former 6000 gal. Gasoline Tanks
 = Pump Islands
 = Plugged Monitor Well 6-15-2017
 = Monitor well associated with Ed Bozarth Trust Fund Site
 = Site Property Boundary
 = Site Benchmark*
 = Basement Observed