

**1 LOCATION OF WATER WELL:** Fraction 1/4 SW 1/4 NW 1/4 NW 1/4 Section Number 19 Township Number T 12 S Range Number 16  E  W  
 County: Shawnee

Street/Rural Address of Well Location; if unknown, distance & direction from nearest town or intersection: If at owner's address, check here  3740 S. Topeka Blvd Topeka, KS 66600

**Global Positioning Systems (GPS) information:**  
 Latitude: \_\_\_\_\_ (in decimal degrees)  
 Longitude: \_\_\_\_\_ (in decimal degrees)  
 Elevation: 1009.53  
 Horizontal Datum:  WGS84,  NAD83,  NAD27  
 Collection Method: \_\_\_\_\_

**2 WATER WELL OWNER:** Tommy McGeeny  
 RR#, St. Address, Box #: \_\_\_\_\_  
 City, State ZIP Code: \_\_\_\_\_

GPS unit (Make/Model: \_\_\_\_\_)  
 Digital Map/Photo,  Topographic Map,  Land Survey  
 Est. Accuracy:  < 3 m,  3-5 m,  5-15 m,  > 15 m

**3 MARK WELL'S LOCATION WITH AN "X" IN SECTION BOX:**

N		
X NW		NE
W		E
SW		SE
S		

**4 DEPTH OF WELL** 19.60 ft.  
 WELL'S STATIC WATER LEVEL 10.57 ft.  
 WELL WAS USED AS:  
 Domestic  Public Water Supply  Dewatering  
 Irrigation  Oil Field Water Supply  Monitoring  
 Feedlot  Domestic (Lawn & Garden)  Injection Well  
 Industrial  Air Conditioning  Other \_\_\_\_\_  
 Was a chemical/bacteriological sample submitted to Department? Yes  No

**5 TYPE OF BLANK CASING USED:**

Steel  RMP (SR)  Wrought  Fiberglass  Other (Specify below) \_\_\_\_\_  
 PVC  ABS  Asbestos-Cement  Concrete Tile \_\_\_\_\_

Blank casing diameter 2 in. Was casing pulled? Yes  No  If yes, how much 3 FT  
 Casing height above or below land surface 36 in.

**6 GROUT PLUG MATERIAL:**  Neat cement  Cement grout  Bentonite  Other \_\_\_\_\_

Grout Plug Intervals: From 19.60 ft. to 3 ft., From \_\_\_\_\_ ft. to \_\_\_\_\_ ft., From \_\_\_\_\_ ft. to \_\_\_\_\_ ft.


What is the nearest source of possible contamination:

<input type="checkbox"/> Septic tank	<input type="checkbox"/> Seepage pit	<input type="checkbox"/> Fuel storage	<input checked="" type="checkbox"/> Other (specify below) <u>Ed Bozarth trust fund site</u>
<input type="checkbox"/> Sewer lines	<input type="checkbox"/> Pit privy	<input type="checkbox"/> Fertilizer storage	
<input type="checkbox"/> Watertight sewer lines	<input type="checkbox"/> Sewage lagoon	<input type="checkbox"/> Insecticide storage	
<input type="checkbox"/> Lateral lines	<input type="checkbox"/> Feedyard	<input type="checkbox"/> Abandoned water well	
<input type="checkbox"/> Cess pool	<input type="checkbox"/> Livestock pens	<input type="checkbox"/> Oil well/Gas well	
Direction from well? <u>West/NW</u>			
How many feet? <u>350</u>			

FROM	TO	PLUGGING MATERIALS	FROM	TO	PLUGGING MATERIALS
0	3	Compact silt/clay			
3	19.60	Hydrated Bentonite chips			

**7 CONTRACTOR'S OR LANDOWNER'S CERTIFICATION:** This water well was plugged under my jurisdiction and was completed on (mo/day/year) 6/15/2017 and this record is true to the best of my knowledge and belief. Kansas Water Well Contractor's License No. 585. This Water Well Record was completed on (mo/day/year) 6/23/2017 under the business name of Associated Environmental, Inc. by (signature) [Signature]


Send one white copy to Kansas Department of Health & Environment, Geology Section, 1000 SW Jackson Street, Ste. 420, Topeka, KS 66612-1367. Send one copy to WATER WELL OWNER and retain one for your records.  
 Visit us at <http://www.kdheks.gov/waterwell/index.html> Telephone 785-296-5524.

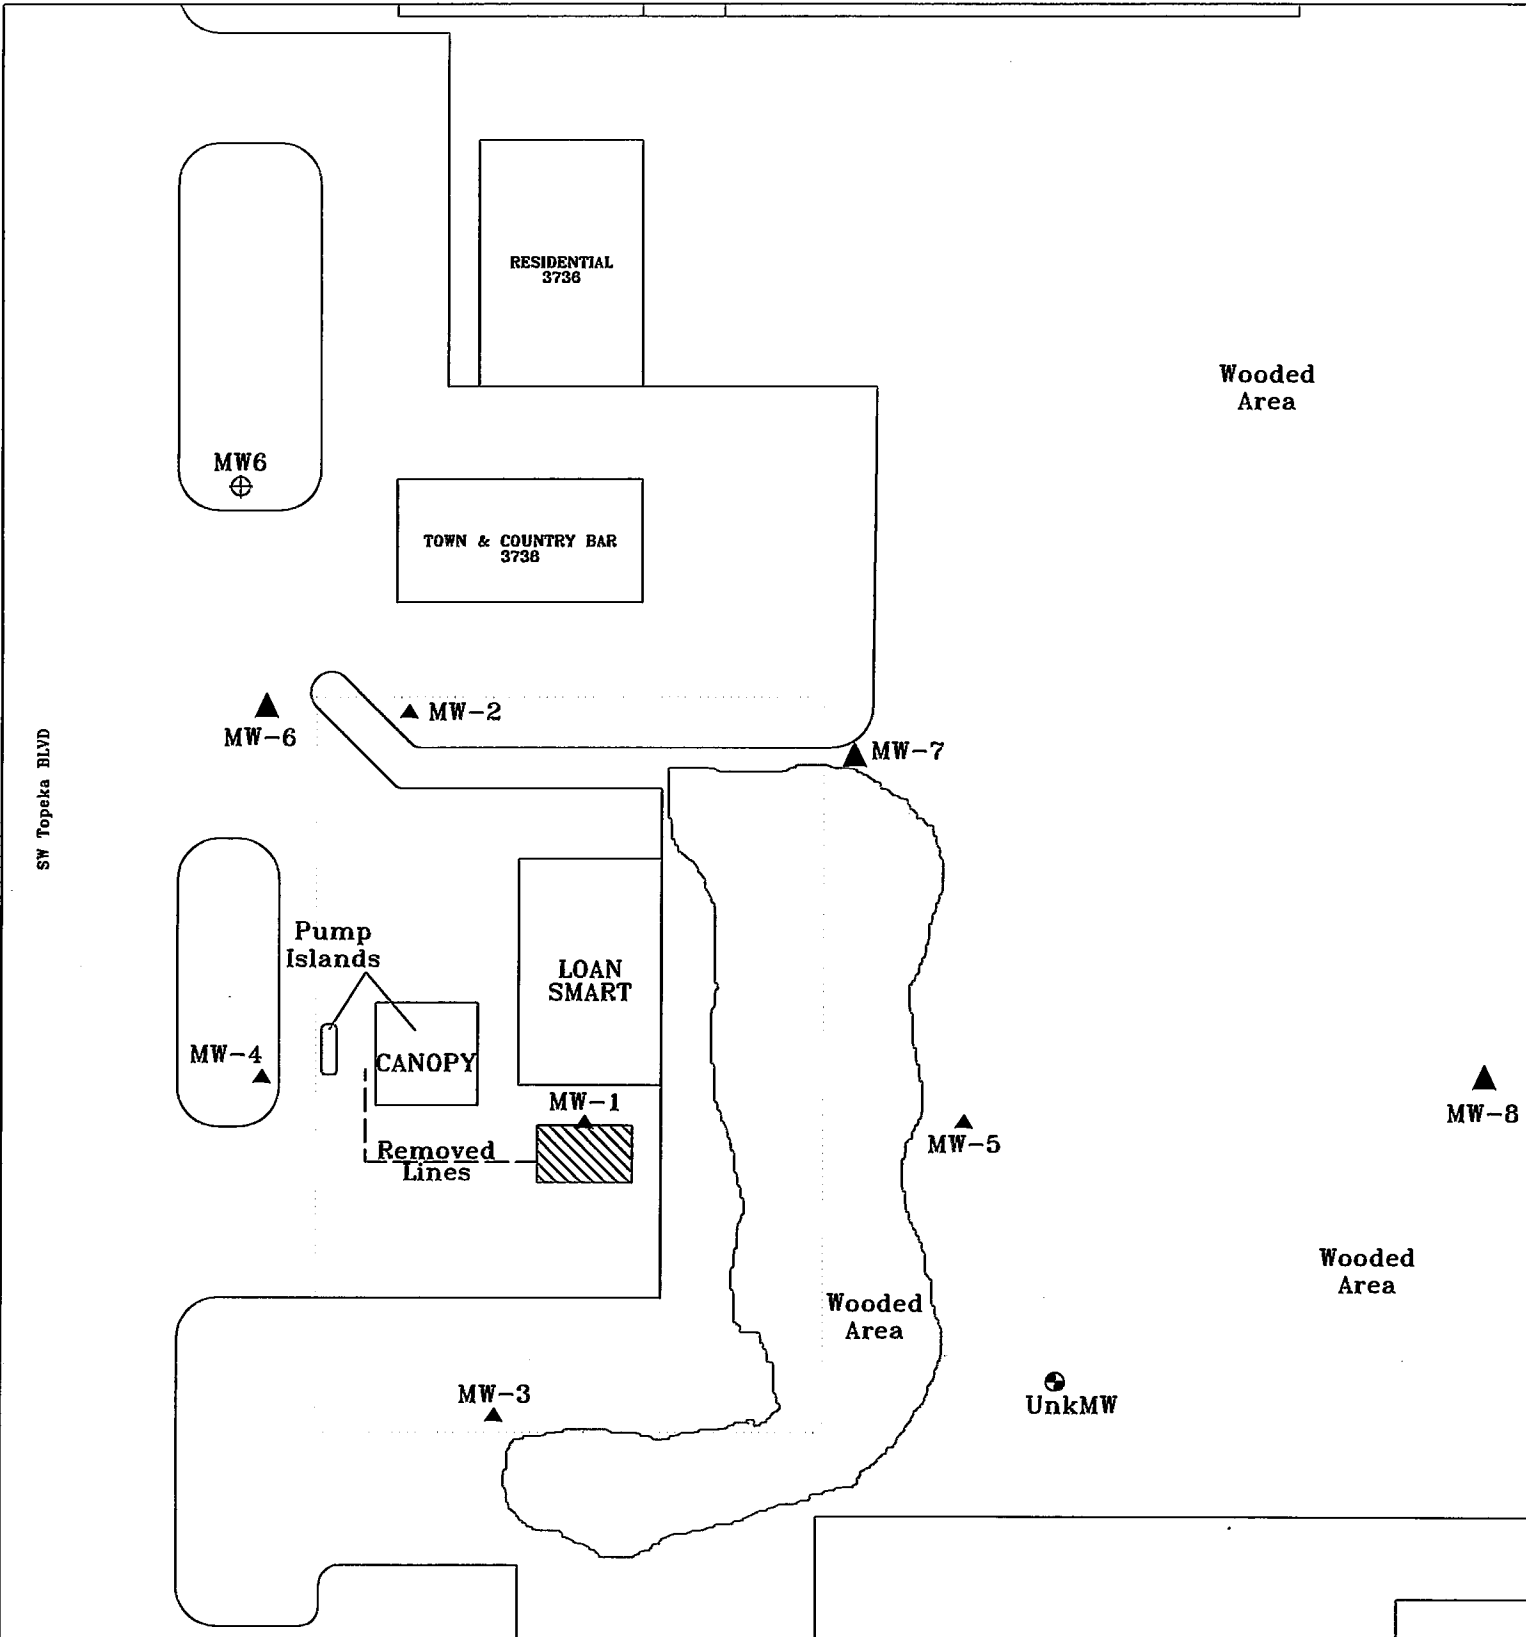

PROJECT: Fina Station-McGreeney Motors  
 ADDRESS: 3740 SW Topeka Blvd  
 LOCATION: Topeka, Kansas  
 DRAWN BY: B. Scott DATE: 05/06/10  
 REVISED BY: C. Roe DATE: 5/6/2010  
 AEI JOB #: TF409 KDHE JOB #: U4-089-01388

TITLE: Site Map  
 ASSOCIATED ENVIRONMENTAL INC.

- LEGEND:
- = (3) Former 6000 gal. Gasoline Tanks
  - = Pump Islands
  - = Plugged Monitor Well 6-15-2017
  - = Monitor well associated with Ed Bozarth Trust Fund Site
  - = Site Property Boundary
  - = Site Benchmark\*
  - = Basement Observed

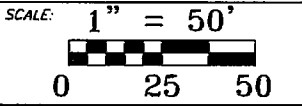

NOTES: \* = Site Benchmark undefined.  
 Monitor wells MW-6, MW-7 & MW-8 plugged in 2001