

**WATER WELL PLUGGING RECORD Form WWC-5P KSA 82a-1212 ID NO.**

MW-4


**1 LOCATION OF WATER WELL:** Fraction 1/4 SW 1/4 NW 1/4 NW 1/4 Section Number 19 Township Number T 12 S Range Number 16  E  W  
 County: Shawnee

Street/Rural Address of Well Location; if unknown, distance & direction from nearest town or intersection: If at owner's address, check here  3740 S. Topeka Blvd Topeka, KS 66600

**Global Positioning Systems (GPS) information:**  
 Latitude: \_\_\_\_\_ (in decimal degrees)  
 Longitude: \_\_\_\_\_ (in decimal degrees)  
 Elevation: 1009.10  
 Horizontal Datum:  WGS84,  NAD83,  NAD27  
 Collection Method:

**2 WATER WELL OWNER:** Tommy McGeeny  
 RR#, St. Address, Box #:  
 City, State ZIP Code:

GPS unit (Make/Model: \_\_\_\_\_)  
 Digital Map/Photo,  Topographic Map,  Land Survey  
 Est. Accuracy:  < 3 m,  3-5 m,  5-15 m,  > 15 m

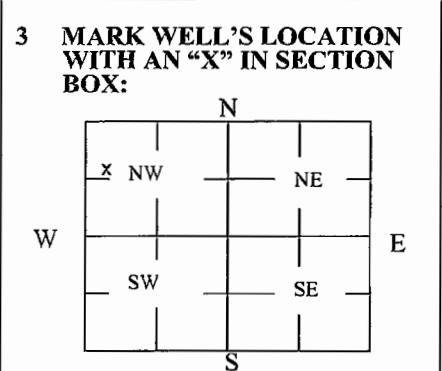

**4 DEPTH OF WELL** 24.48 ft.  
 WELL'S STATIC WATER LEVEL 6.15 ft  
 WELL WAS USED AS:  
 Domestic  Public Water Supply  Dewatering  
 Irrigation  Oil Field Water Supply  Monitoring  
 Feedlot  Domestic (Lawn & Garden)  Injection Well  
 Industrial  Air Conditioning  Other \_\_\_\_\_  
 Was a chemical/bacteriological sample submitted to Department? Yes  No

**5 TYPE OF BLANK CASING USED:**  
 Steel  RMP (SR)  Wrought  Fiberglass  Other (Specify below)  
 PVC  ABS  Asbestos-Cement  Concrete Tile  
 Blank casing diameter 2 in. Was casing pulled? Yes  No  If yes, how much 3 FT  
 Casing height above or below land surface 36 in.


**6 GROUT PLUG MATERIAL:**  Neat cement  Cement grout  Bentonite  Other \_\_\_\_\_  
 Grout Plug Intervals: From 24.48 ft. to 3 ft., From \_\_\_\_\_ ft. to \_\_\_\_\_ ft., From \_\_\_\_\_ ft. to \_\_\_\_\_ ft.

What is the nearest source of possible contamination:  
 Septic tank  Seepage pit  Fuel storage  Other (specify below)  
 Sewer lines  Pit privy  Fertilizer storage Ed Bozarth trust fund site  
 Watertight sewer lines  Sewage lagoon  Insecticide storage  
 Lateral lines  Feedyard  Abandoned water well Direction from well? West/NW  
 Cess pool  Livestock pens  Oil well/Gas well How many feet? 350

FROM	TO	PLUGGING MATERIALS	FROM	TO	PLUGGING MATERIALS
0	3	Compact silt/clay			
3	24.48	Hydrated Bentonite chips			

**7 CONTRACTOR'S OR LANDOWNER'S CERTIFICATION:** This water well was plugged under my jurisdiction and was completed on (mo/day/year) 6/15/2017 and this record is true to the best of my knowledge and belief. Kansas Water Well Contractor's License No. 585. This Water Well Record was completed on (mo/day/year) 6/28/2017 under the business name of Associated Environmental, Inc. by (signature) [Signature]

Send one white copy to Kansas Department of Health & Environment, Geology Section, 1000 SW Jackson Street, Ste. 420, Topeka, KS 66612-1367. Send one copy to WATER WELL OWNER and retain one for your records.  
 Visit us at <http://www.kdheks.gov/waterwell/index.html> Telephone 785-296-5524.

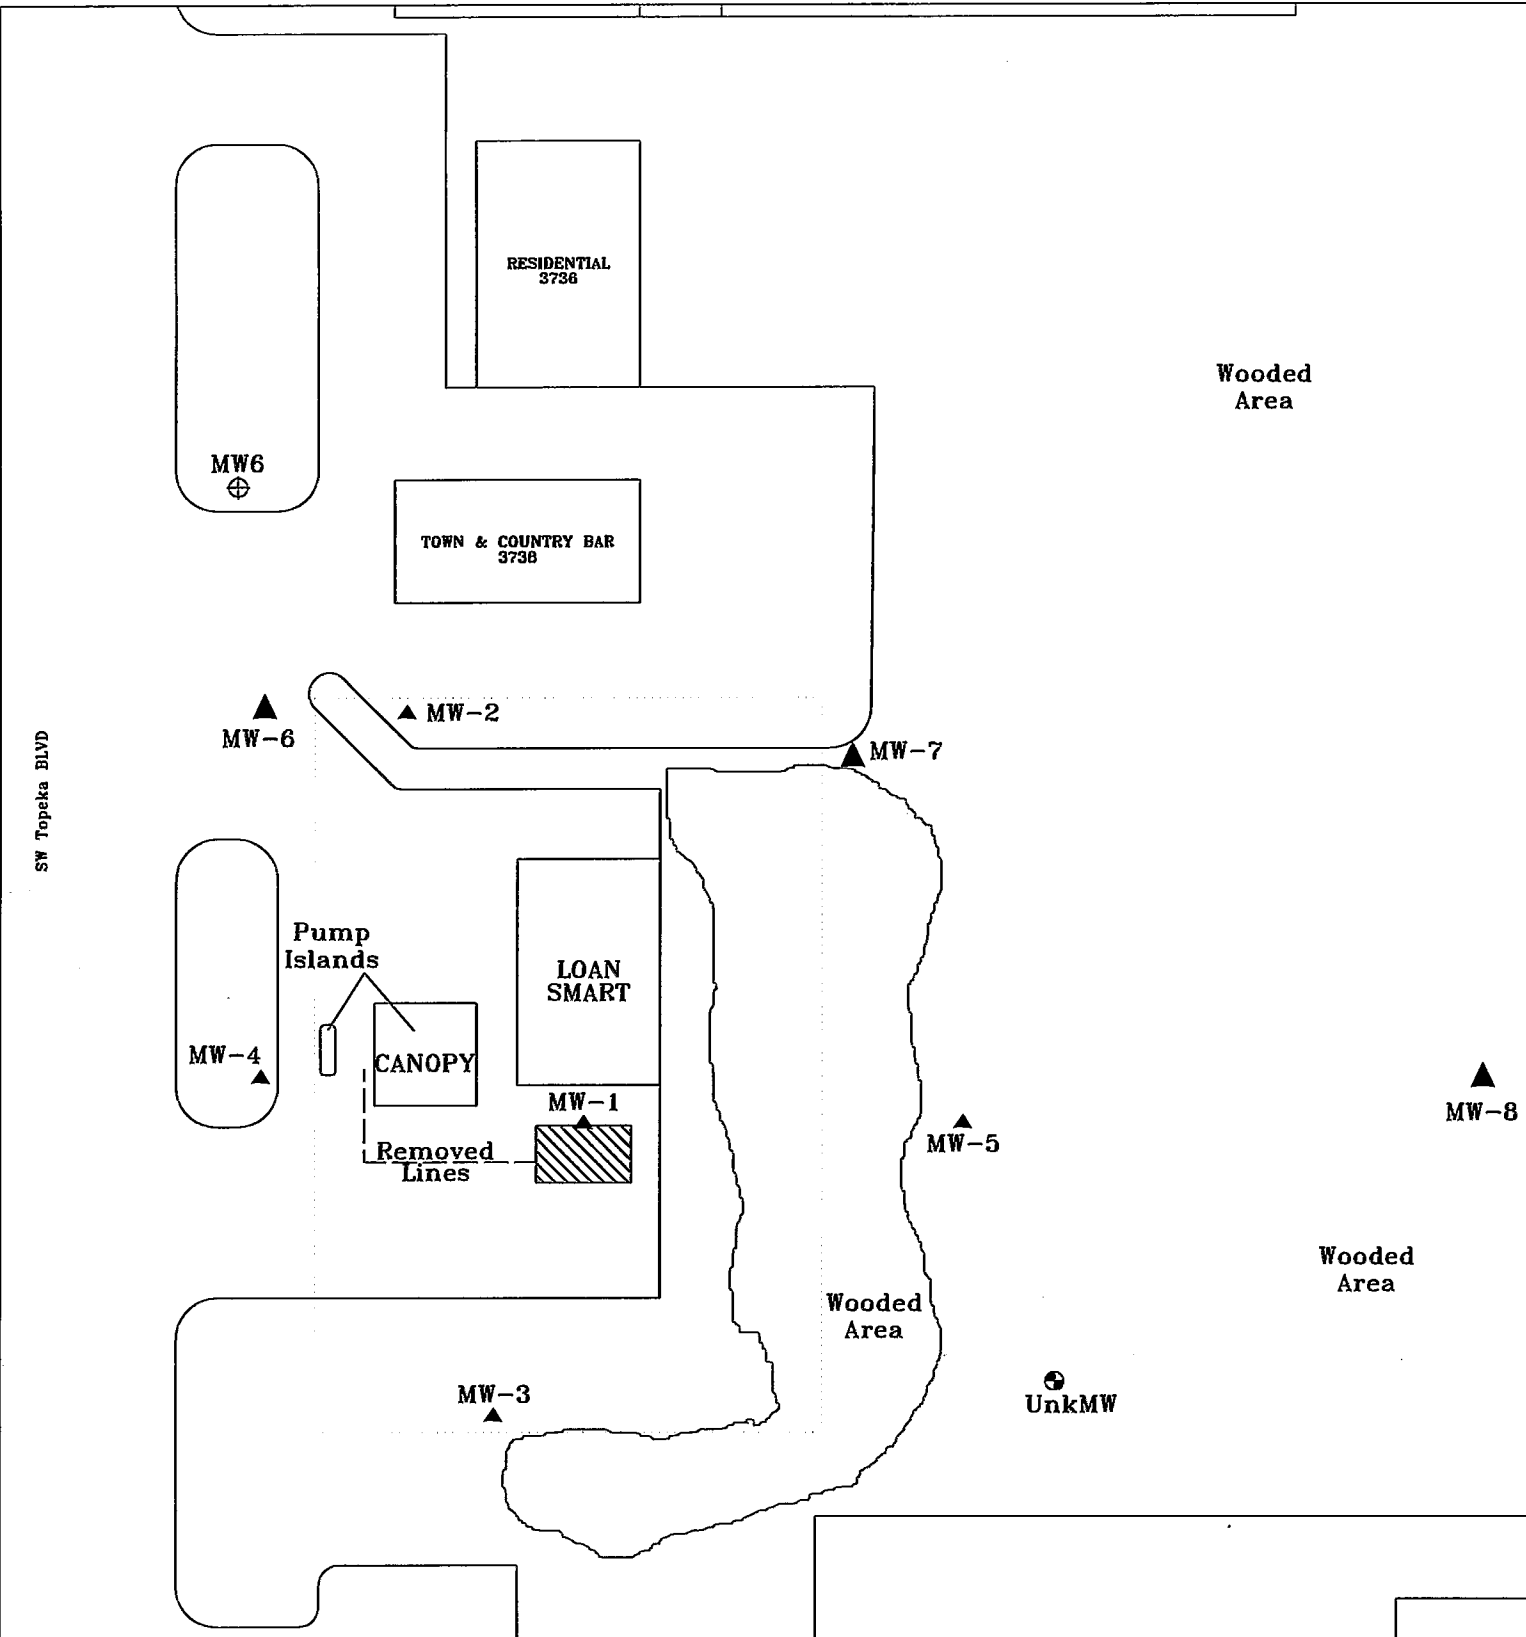

PROJECT: Fina Station-McGreeney Motors  
 ADDRESS: 3740 SW Topeka Blvd  
 LOCATION: Topeka, Kansas  
 DRAWN BY: B. Scott DATE: 05/06/10  
 REVISED BY: C. Roe DATE: 5/6/2010  
 AET JOB #: TF409 KOHE JOB #: U4-089-01388  
 SCALE: 1" = 50'  
 0 25 50

TITLE: Site Map  
 ASSOCIATED ENVIRONMENTAL INC.  
 NOTES: • = Site Benchmark undefined.  
 Monitor wells MW-6, MW-7 & MW-8 plugged in 2001

LEGEND:  
 = (3) Former 6000 gal. Gasoline Tanks  
 = Pump Islands  
 = Plugged Monitor Well 6-15-2017  
 = Monitor well associated with Ed Bozarth Trust Fund Site  
 = Site Property Boundary  
 = Site Benchmark\*  
 = Basement Observed