

WATER WELL PLUGGING RECORD Form WWC-5P KSA 82a-1212 ID NO.


MW-5

1 LOCATION OF WATER WELL: County: Shawnee	Fraction ¼ SW ¼ NW ¼ NW ¼	Section Number 19	Township Number T 12 S	Range Number 16 <input checked="" type="checkbox"/> E <input type="checkbox"/> W
---	------------------------------	----------------------	---------------------------	---

Street/Rural Address of Well Location; if unknown, distance & direction from nearest town or intersection: If at owner's address, check here 3740 S. Topeka Blvd Topeka, Kansas 66600

Global Positioning Systems (GPS) information:
 Latitude: _____ (in decimal degrees)
 Longitude: _____ (in decimal degrees)
 Elevation: 999.92
 Horizontal Datum: WGS84, NAD83, NAD27
 Collection Method:
 GPS unit (Make/Model: _____)
 Digital Map/Photo, Topographic Map, Land Survey
 Est. Accuracy: < 3 m, 3-5 m, 5-15 m, > 15 m

2 WATER WELL OWNER: Terry McGeeny
 RR#, St. Address, Box #:
 City, State ZIP Code:

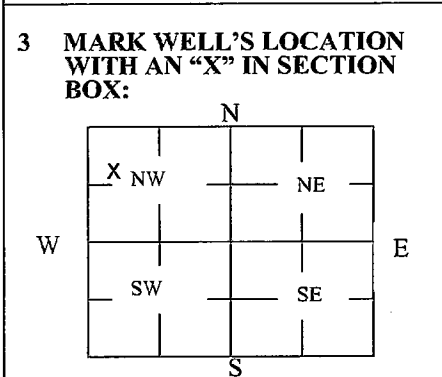

4 DEPTH OF WELL 20.73 ft.
 WELL'S STATIC WATER LEVEL 7.15 ft
 WELL WAS USED AS:
 Domestic Public Water Supply Dewatering
 Irrigation Oil Field Water Supply Monitoring
 Feedlot Domestic (Lawn & Garden) Injection Well
 Industrial Air Conditioning Other _____
 Was a chemical/bacteriological sample submitted to Department? Yes No

5 TYPE OF BLANK CASING USED:
 Steel RMP (SR) Wrought Fiberglass Other (Specify below)
 PVC ABS Asbestos-Cement Concrete Tile
 Blank casing diameter 2 in. Was casing pulled? Yes No If yes, how much 3 FT
 Casing height above or below land surface 36 in.


6 GROUT PLUG MATERIAL: Neat cement Cement grout Bentonite Other _____
 Grout Plug Intervals: From 3 ft. to 20.73ft., From _____ ft. to _____ ft., From _____ ft. to _____ ft.

What is the nearest source of possible contamination:
 Septic tank Seepage pit Fuel storage Other (specify below)
 Sewer lines Pit privy Fertilizer storage Ed Bozarth trust fund site
 Watertight sewer lines Sewage lagoon Insecticide storage
 Lateral lines Feedyard Abandoned water well Direction from well? West/NW
 Cess pool Livestock pens Oil well/Gas well How many feet? 350

FROM	TO	PLUGGING MATERIALS	FROM	TO	PLUGGING MATERIALS
0	3	Compacted Silt/Clay			
3	20.73	Hydrated Bentonite Chips			

7 CONTRACTOR'S OR LANDOWNER'S CERTIFICATION: This water well was plugged under my jurisdiction and was completed on (mo/day/year) 6/15/2017 and this record is true to the best of my knowledge and belief. Kansas Water Well Contractor's License No. 585. This Water Well Record was completed on (mo/day/year) 6/28/2017 under the business name of Associated Environmental, Inc. by (signature) *[Signature]*

Send one white copy to Kansas Department of Health & Environment, Geology Section, 1000 SW Jackson Street, Ste. 420, Topeka, KS 66612-1367. Send one copy to WATER WELL OWNER and retain one for your records.
 Visit us at <http://www.kdheks.gov/waterwell/index.html> Telephone 785-296-5524.

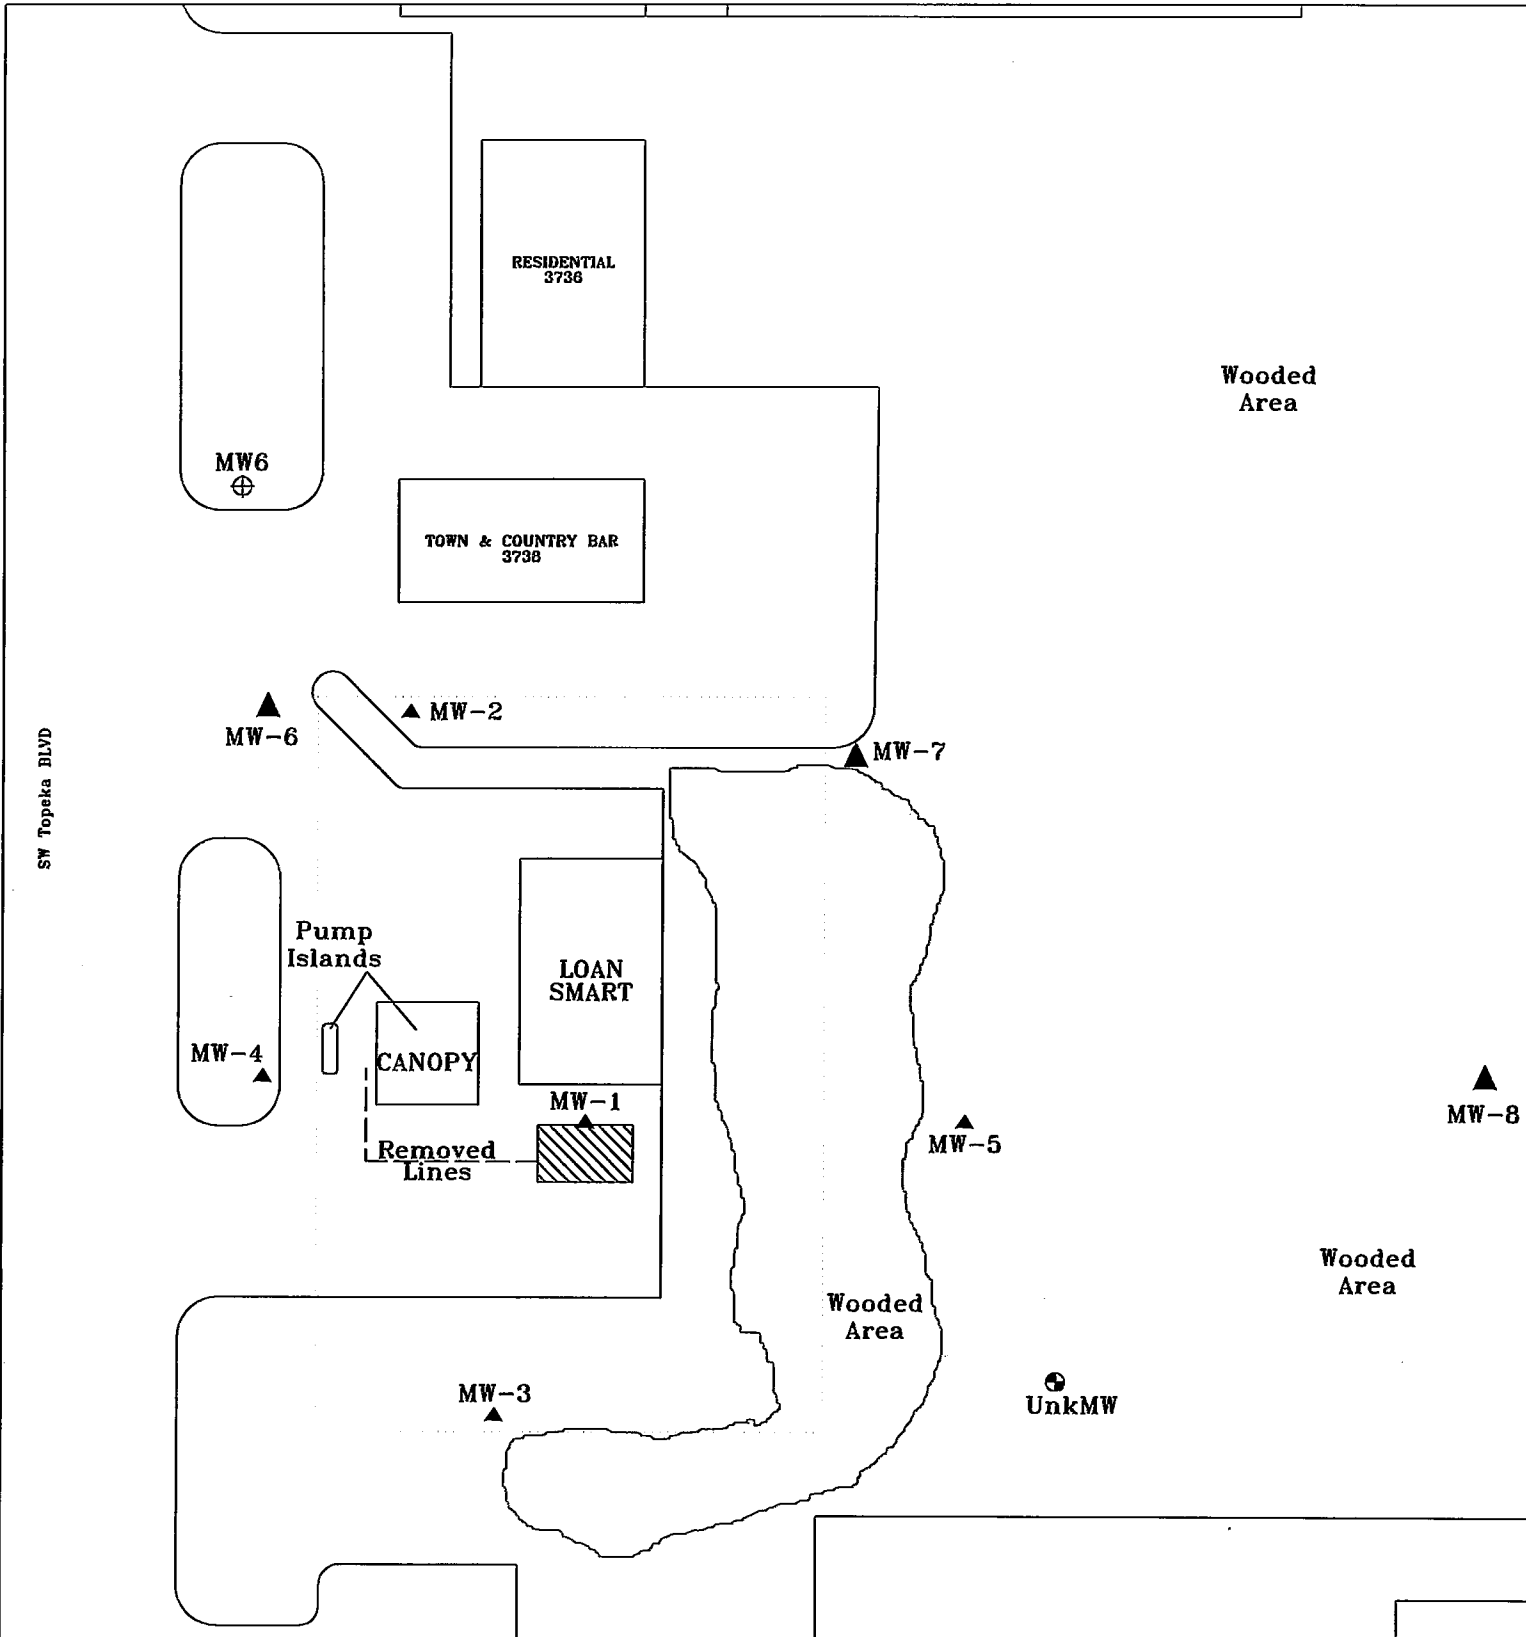

PROJECT: Fina Station-McGreeney Motors
 ADDRESS: 3740 SW Topeka Blvd
 LOCATION: Topeka, Kansas
 DRAWN BY: B. Scott DATE: 05/06/10
 REVISED BY: C. Roe DATE: 5/6/2010
 AEI JOB #: TF409 KDIHE JOB #: U4-089-01388
 SCALE: 1" = 50'
 0 25 50

TITLE: Site Map
 ASSOCIATED ENVIRONMENTAL INC.
 NOTES: * = Site Benchmark undefined.
 Monitor wells MW-6, MW-7 & MW-8 plugged in 2001

LEGEND:
 = (3) Former 6000 gal. Gasoline Tanks
 = Pump Islands
 = Plugged Monitor Well 6-15-2017
 = Monitor well associated with Ed Bozarth Trust Fund Site
 = Site Property Boundary
 = North
 = Site Benchmark*
 = Basement Observed