

1 LOCATION OF WATER WELL: County: Shawnee Fraction SE 1/4 SW 1/4 SE 1/4 NW 1/4 Section Number 6 Township Number T 12 S Range Number 16 [X] E [] W


Street/Rural Address of Well Location: if unknown, distance & direction from nearest town or intersection: If at owner's address, check here []
~70' N of 1700 Topeka Blvd., Topeka, KS

Global Positioning Systems (GPS) information: Latitude: NA (in decimal degrees) Longitude: NA (in decimal degrees) Elevation: NA

Horizontal Datum [] WGS84, [] NAD83, [] NAD27 Collection Method:

2 WATER WELL OWNER: Kwik Shop Inc. RR#, St. Address, Box #: 734 E 4th City, State ZIP Code: Hutchinson, KS

[] GPS unit (Make/model: _____) [] Digital Map/Photo, [] Topographic Map [] Land Survey Est. Accuracy: [] <3 m, [] 3-5 m, [] 5-15 m, [] >15 m

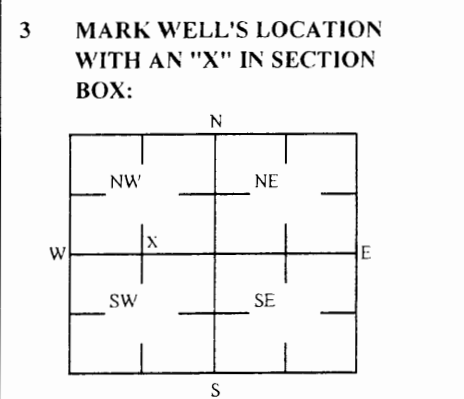

4 DEPTH OF WELL 10.5 ft. WELL'S STATIC WATER LEVEL _____ ft. WELL WAS USED AS: [] Domestic [] Irrigation [] Feedlot [] Industrial [] Public Water Supply [] Oil Field Water Supply [] Domestic (Lawn & Garden) [] Air Conditioning [] Dewatering [X] Monitoring [] Injection Well [] Other _____ Was a chemical/bacteriological sample submitted to Department? Yes [] No [X]

5 TYPE OF BLANK CASING USED: [] Steel [X] PVC [] RMP (SR) [] ABS [] Wrought [] Asbestos-Cement [] Fiberglass [] Concrete Tile [] Other (Specific below) Blank casing diameter 2 in. Was casing pulled? Yes [X] No [] If yes, how much 3' Casing height above or below land surface NA in.

6 GROUT PLUG MATERIAL: [] Neat cement [] Cement grout [X] Bentonite [X] Other Asphalt: 0-0.5'; Soil: 0.5-3' Grout Plug Intervals: From 3 ft to 10.5 ft. From _____ ft to _____ ft. From _____ ft to _____ ft. What is the nearest source of possible contamination: [] Septic tank [] Sewer lines [] Watertight sewer lines [] Lateral lines [] Cess pool [] Seepage pit [] Pit privy [] Sewage lagoon [] Feed yard [] Livestock pens [] Fuel storage [] Fertilizer storage [] Insecticide storage [] Abandoned water well [] Oil well/Gas well [] Other (specify below) _____ Direction from well? _____ How many feet? _____

Table with columns: FROM, TO, PLUGGING MATERIALS. Rows: 0-0.5 Asphalt, 0.5-3 Soil, 3-10.5 Bentonite. Includes KDHE ID: Kwik Shop #729: U4-089-14746

7 CONTRACTOR'S OR LANDOWNER'S CERTIFICATION: This water well was plugged under my jurisdiction and was completed on (mo/day/year) 7/2-3/18 and this record is true to the best of my knowledge and belief. Kansas Water Contractor's License No. 757. This Water Well Record was completed on (mo/day/year) 7/6/2018 under the business name of Larsen & Associates, Inc. By (signature) [Signature]

Send one white copy to Kansas Department of Health & Environment, Geology Section, 600 SW Jackson Street, Ste. 420, Topeka, KS 66612-1367. Visit us at http://www.kdheks.gov/waterwell/index.html Telephone 785-296-5524.