


1 LOCATION OF WATER WELL: County: Shawnee Fraction 1/4 NW 1/4 NE 1/4 SW 1/4 Section Number 6 Township Number T 12 S Range Number 16 [X] E [] W

Street/Rural Address of Well Location: 1732 SW Topeka Blvd., Topeka, KS. Global Positioning Systems (GPS) information: Latitude: NA, Longitude: NA, Elevation: NA.

2 WATER WELL OWNER: Capital City Oil Company, RR#, St. Address. Box #: PO Box 618, City, State ZIP Code: Topeka KS.

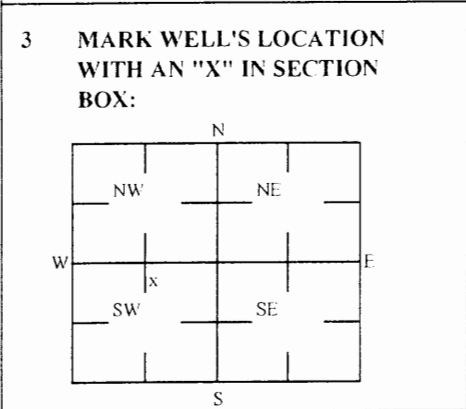

4 DEPTH OF WELL 23.6 ft. WELL'S STATIC WATER LEVEL ft. WELL WAS USED AS: [] Domestic, [] Irrigation, [] Feedlot, [] Industrial, [] Public Water Supply, [] Oil Field Water Supply, [] Domestic (Lawn & Garden), [] Air Conditioning, [] Dewatering, [X] Monitoring, [] Injection Well, [] Other.

5 TYPE OF BLANK CASING USED: [X] Steel, [] RMP (SR), [] Wrought, [] Fiberglass, [] Other (Specific below), [X] PVC, [] ABS, [] Asbestos-Cement, [] Concrete Tile.

6 GROUT PLUG MATERIAL: [] Neat cement, [] Cement grout, [X] Bentonite, [X] Other Soil: 0-3'. Grout Plug Intervals: From 3 ft to 23.6 ft.

Table with columns: FROM, TO, PLUGGING MATERIALS. Rows: 0 to 3 (Soil), 3 to 23.6 (Bentonite).

7 CONTRACTOR'S OR LANDOWNER'S CERTIFICATION: This water well was plugged under my jurisdiction and was completed on (mo/day/year) 7/2-3/18 and this record is true to the best of my knowledge and belief.