

**WATER WELL RECORD Form WWC-5**

Division of Water Resources App. No.

39.01136

Well ID **MW8**

Original Record  Correction  Change in Well Use

**1 LOCATION OF WATER WELL:**  
 County: **SHAWNEE** Fraction **NE 1/4 NW 1/4 SW 1/4 NW 1/4** Section Number **18** Township Number **T 12 S** Range Number **R 16 E W**

**2 WELL OWNER:** Last Name: **KANSAS DEPT. OF TRANSPORTATION** First: **3210 SW TOPEKA BLVD**  
 Address: **3210 SW TOPEKA BLVD** Street or Rural Address where well is located (if unknown, distance and direction from nearest town or intersection):  
 City: **TOPEKA** State: **KS** ZIP: **66611**

**3 LOCATE WELL WITH "X" IN SECTION BOX:**  
 N  
  
 W E  
 S  
 -----1 mile-----

**4 DEPTH OF COMPLETED WELL:** ..... **25** ..... ft.  
 Depth(s) Groundwater Encountered: 1) ..... ft.  
 2) ..... ft. 3) ..... ft., or 4)  Dry Well  
 WELL'S STATIC WATER LEVEL: ..... **23.75** ..... ft.  
 below land surface, measured on (mo-day-yr) ..... **8/9/18** .....  
 above land surface, measured on (mo-day-yr) .....  
 Pump test data: Well water was ..... ft.  
 after ..... hours pumping ..... gpm  
 Well water was ..... ft.  
 after ..... hours pumping ..... gpm  
 Estimated Yield: ..... gpm  
 Bore Hole Diameter: ..... in. to ..... ft. and  
 ..... in. to ..... ft.

**5 Latitude:** ..... **39.01136** ..... (decimal degrees)  
**Longitude:** ..... **95.68663** ..... (decimal degrees)  
 Horizontal Datum:  WGS 84  NAD 83  NAD 27  
 Source for Latitude/Longitude:  
 GPS (unit make/model: .....)  
 (WAAS enabled?  Yes  No)  
 Land Survey  Topographic Map  
 Online Mapper: .....  
**6 Elevation:** **979.43** ..... ft.  Ground Level  TOC  
 Source:  Land Survey  GPS  Topographic Map  
 Other .....

**7 WELL WATER TO BE USED AS:**

1. <input type="checkbox"/> Domestic: <input type="checkbox"/> Household <input type="checkbox"/> Lawn & Garden <input type="checkbox"/> Livestock	2. <input type="checkbox"/> Irrigation	3. <input type="checkbox"/> Feedlot	4. <input type="checkbox"/> Industrial	5. <input type="checkbox"/> Public Water Supply: well ID .....	6. <input type="checkbox"/> Dewatering: how many wells? .....	7. <input type="checkbox"/> Aquifer Recharge: well ID .....	8. <input checked="" type="checkbox"/> Monitoring: well ID <b>MW8</b>	9. Environmental Remediation: well ID .....	<input type="checkbox"/> Air Sparge <input type="checkbox"/> Soil Vapor Extraction <input type="checkbox"/> Recovery <input type="checkbox"/> Injection	10. <input type="checkbox"/> Oil Field Water Supply: lease .....	11. Test Hole: well ID .....	12. Geothermal: how many bores? .....	a) <input type="checkbox"/> Closed Loop <input type="checkbox"/> Horizontal <input type="checkbox"/> Vertical b) <input type="checkbox"/> Open Loop <input type="checkbox"/> Surface Discharge <input type="checkbox"/> Inj. of Water	13. <input type="checkbox"/> Other (specify): .....
---	--	-------------------------------------	--	--	---	---	---	---	--	--	------------------------------	---------------------------------------	--	---


**Was a chemical/bacteriological sample submitted to KDHE?**  Yes  No If yes, date sample was submitted: .....  
 Water well disinfected?  Yes  No

**8 TYPE OF CASING USED:**  Steel  PVC  Other ..... CASING JOINTS:  Glued  Clamped  Welded  Threaded  
 Casing diameter ..... **2** ..... in. to ..... **25** ..... ft., Diameter ..... in. to ..... ft., Diameter ..... in. to ..... ft.  
 Casing height above land surface ..... in. Weight ..... lbs./ft. Wall thickness or gauge No. ....  
 TYPE OF SCREEN OR PERFORATION MATERIAL:  
 Steel  Stainless Steel  Fiberglass  PVC  Other (Specify) .....  
 Brass  Galvanized Steel  Concrete tile  None used (open hole)  
 SCREEN OR PERFORATION OPENINGS ARE:  
 Continuous Slot  Mill Slot  Gauze Wrapped  Torch Cut  Drilled Holes  Other (Specify) .....  
 Louvered Shutter  Key Punched  Wire Wrapped  Saw Cut  None (Open Hole)  
 SCREEN-PERFORATED INTERVALS: From **15** ..... ft. to **25** ..... ft., From ..... ft. to ..... ft., From ..... ft. to ..... ft.  
 GRAVEL PACK INTERVALS: From **13** ..... ft. to **25** ..... ft., From ..... ft. to ..... ft., From ..... ft. to ..... ft.

**9 GROUT MATERIAL:**  Neat cement  Cement grout  Bentonite  Other **Concrete Surface Completion 0-1**  
 Grout Intervals: From **0** ..... ft. to **1** ..... ft., From **1** ..... ft. to **11** ..... ft., From **11** ..... ft. to **13** ..... ft.  
**Nearest source of possible contamination:**  
 Septic Tank  Lateral Lines  Pit Privy  Livestock Pens  Insecticide Storage  
 Sewer Lines  Cess Pool  Sewage Lagoon  Fuel Storage  Abandoned Water Well  
 Watertight Sewer Lines  Seepage Pit  Feedyard  Fertilizer Storage  Oil Well/Gas Well  
 Other (Specify) .....  
 Direction from well? ..... Distance from well? .....

10 FROM	TO	LITHOLOGIC LOG	FROM	TO	LITHO. LOG (cont.) or PLUGGING INTERVALS
0	.5	ASPHALT			
.5	12	SILTY CLAY			
12	25	CLAY			

**11 CONTRACTOR'S OR LANDOWNER'S CERTIFICATION:** This water well was  constructed,  reconstructed, or  plugged under my jurisdiction and was completed on (mo-day-year) **8/8/18** ..... and this record is true to the best of my knowledge and belief.  
 Kansas Water Well Contractor's License No. **585** ..... This Water Well Record was completed on (mo-day-year) **8/21/18** .....  
 under the business name of **ASSOCIATED ENVIRONMENTAL INC.** ..... Signature

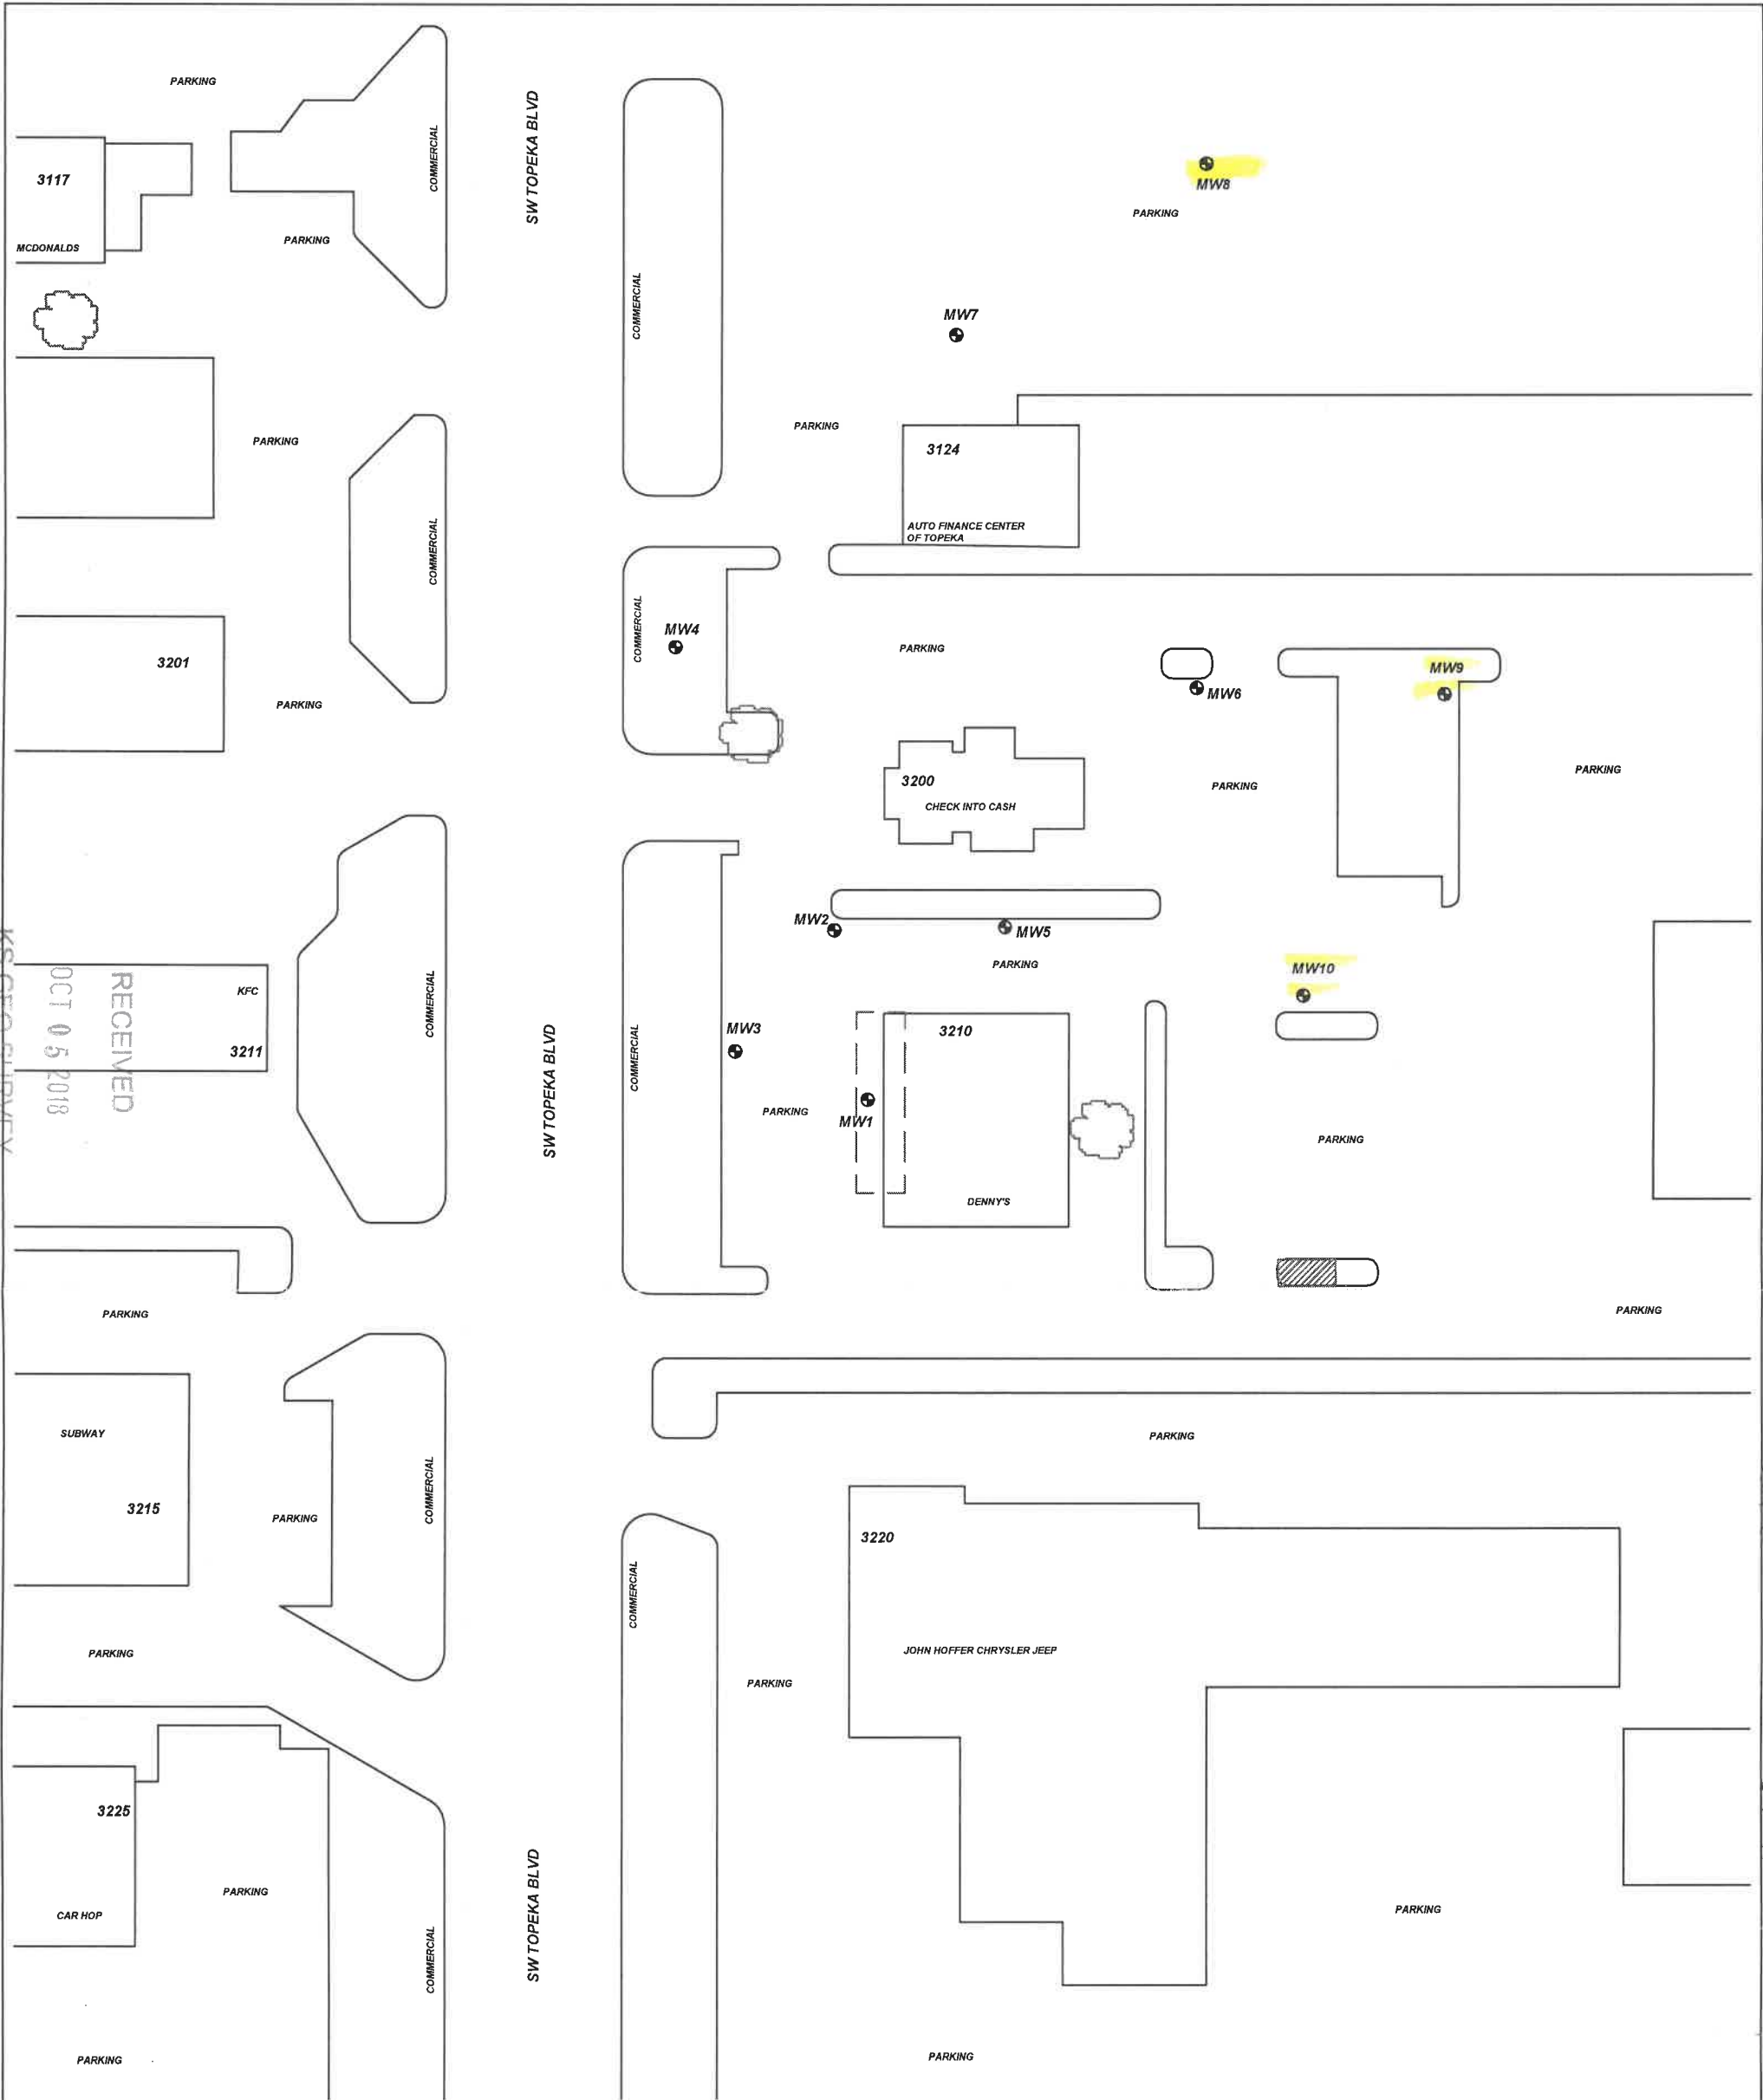

KS GEO SURVEY

RECEIVED  
OCT 05 2018

**PROJECT:** KANSAS DEPT OF TRANSPORTATION

**ADDRESS:** 3210 SW TOPEKA BLVD

**LOCATION:** TOPEKA, KS

**DRAWN BY:** B. STALNAKER **DATE:** 6/4/18

**REVISED BY:** B. STALNAKER **DATE:** 6/26/18

**AEI JOB #:** TF248 **KDHE JOB #:** U4-089-01495

**TITLE:**

**ASSOCIATED ENVIRONMENTAL INC.**

**LEGEND:**

- = FORMER UST BASIN AND PUMP ISLANDS
- = FORMER UST BASIN
- = MONITORING WELL
- = SUBJECT PROPERTY

**RECEIVED**  
**OCT 01 2018**  
**BUREAU OF WATER**

**SCALE:** 1" = 100'

**NOTES:**  
No basements observed within 500'.

SW NW