


1 LOCATION OF WATER WELL: Fraction ¼ SW ¼ NW ¼ NW ¼ Section Number 18 Township Number T 12 S Range Number 16 E W
 County: Shawnee

Street/Rural Address of Well Location; if unknown, distance & direction from nearest town or intersection: If at owner's address, check here

Global Positioning Systems (GPS) information:
 Latitude: 39.0124294 (in decimal degrees)
 Longitude: 95.6865385 (in decimal degrees)
 Elevation: 991.85 TOC
 Horizontal Datum: WGS84, NAD83, NAD27
 Collection Method:

2 WATER WELL OWNER: KDOT
 RR#, St. Address, Box #: 3210 SW TOPEKA BLVD
 City, State ZIP Code: TOPEKA, KS 66611

GPS unit (Make/Model: _____)
 Digital Map/Photo, Topographic Map, Land Survey
 Est. Accuracy: < 3 m, 3-5 m, 5-15 m, > 15 m

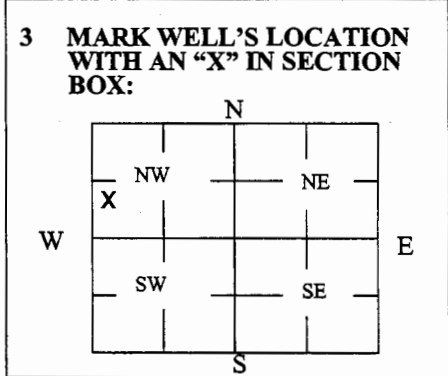

4 DEPTH OF WELL 18.75 ft.
 WELL'S STATIC WATER LEVEL 10.49 ft.
 WELL WAS USED AS:
 Domestic Public Water Supply Dewatering
 Irrigation Oil Field Water Supply Monitoring
 Feedlot Domestic (Lawn & Garden) Injection Well
 Industrial Air Conditioning Other _____

Was a chemical/bacteriological sample submitted to Department? Yes No

5 TYPE OF BLANK CASING USED:

Steel RMP (SR) Wrought Fiberglass Other (Specify below) _____
 PVC ABS Asbestos-Cement Concrete Tile

Blank casing diameter 2 in. Was casing pulled? Yes No If yes, how much 3 ft
 Casing height above or below land surface 36 in.

6 GROUT PLUG MATERIAL: Neat cement Cement grout Bentonite Other _____

Grout Plug Intervals: From 3 ft. to 18.75 ft., From _____ ft. to _____ ft., From _____ ft. to _____ ft.


What is the nearest source of possible contamination:
 Septic tank Sewer lines Watertight sewer lines Lateral lines Cess pool
 Seepage pit Pit privy Sewage lagoon Feedyard Livestock pens
 Fuel storage Fertilizer storage Insecticide storage Abandoned water well Oil well/Gas well Other (specify below) _____

Direction from well? EAST
 How many feet? 200

FROM	TO	PLUGGING MATERIALS	FROM	TO	PLUGGING MATERIALS
0	0.5	Asphalt			
0.5	3	Compacted silt/clay			
3	18.75	Hydrated Bentonite chips			
					KDOT; U4-089-01495

7 CONTRACTOR'S OR LANDOWNER'S CERTIFICATION: This water well was plugged under my jurisdiction and was completed on (mo/day/year) 4/2/19 and this record is true to the best of my knowledge and belief. Kansas Water Well Contractor's License No. 585. This Water Well Record was completed on (mo/day/year) 4/25/19 under the business name of Associated Environmental, Inc. by (signature) [Signature]

Send one white copy to Kansas Department of Health & Environment, Geology Section, 1000 SW Jackson Street, Ste. 420, Topeka, KS 66612-1367. Send one copy to WATER WELL OWNER and retain one for your records.
 Visit us at <http://www.kdheks.gov/waterwell/index.html> Telephone 785-296-5524.

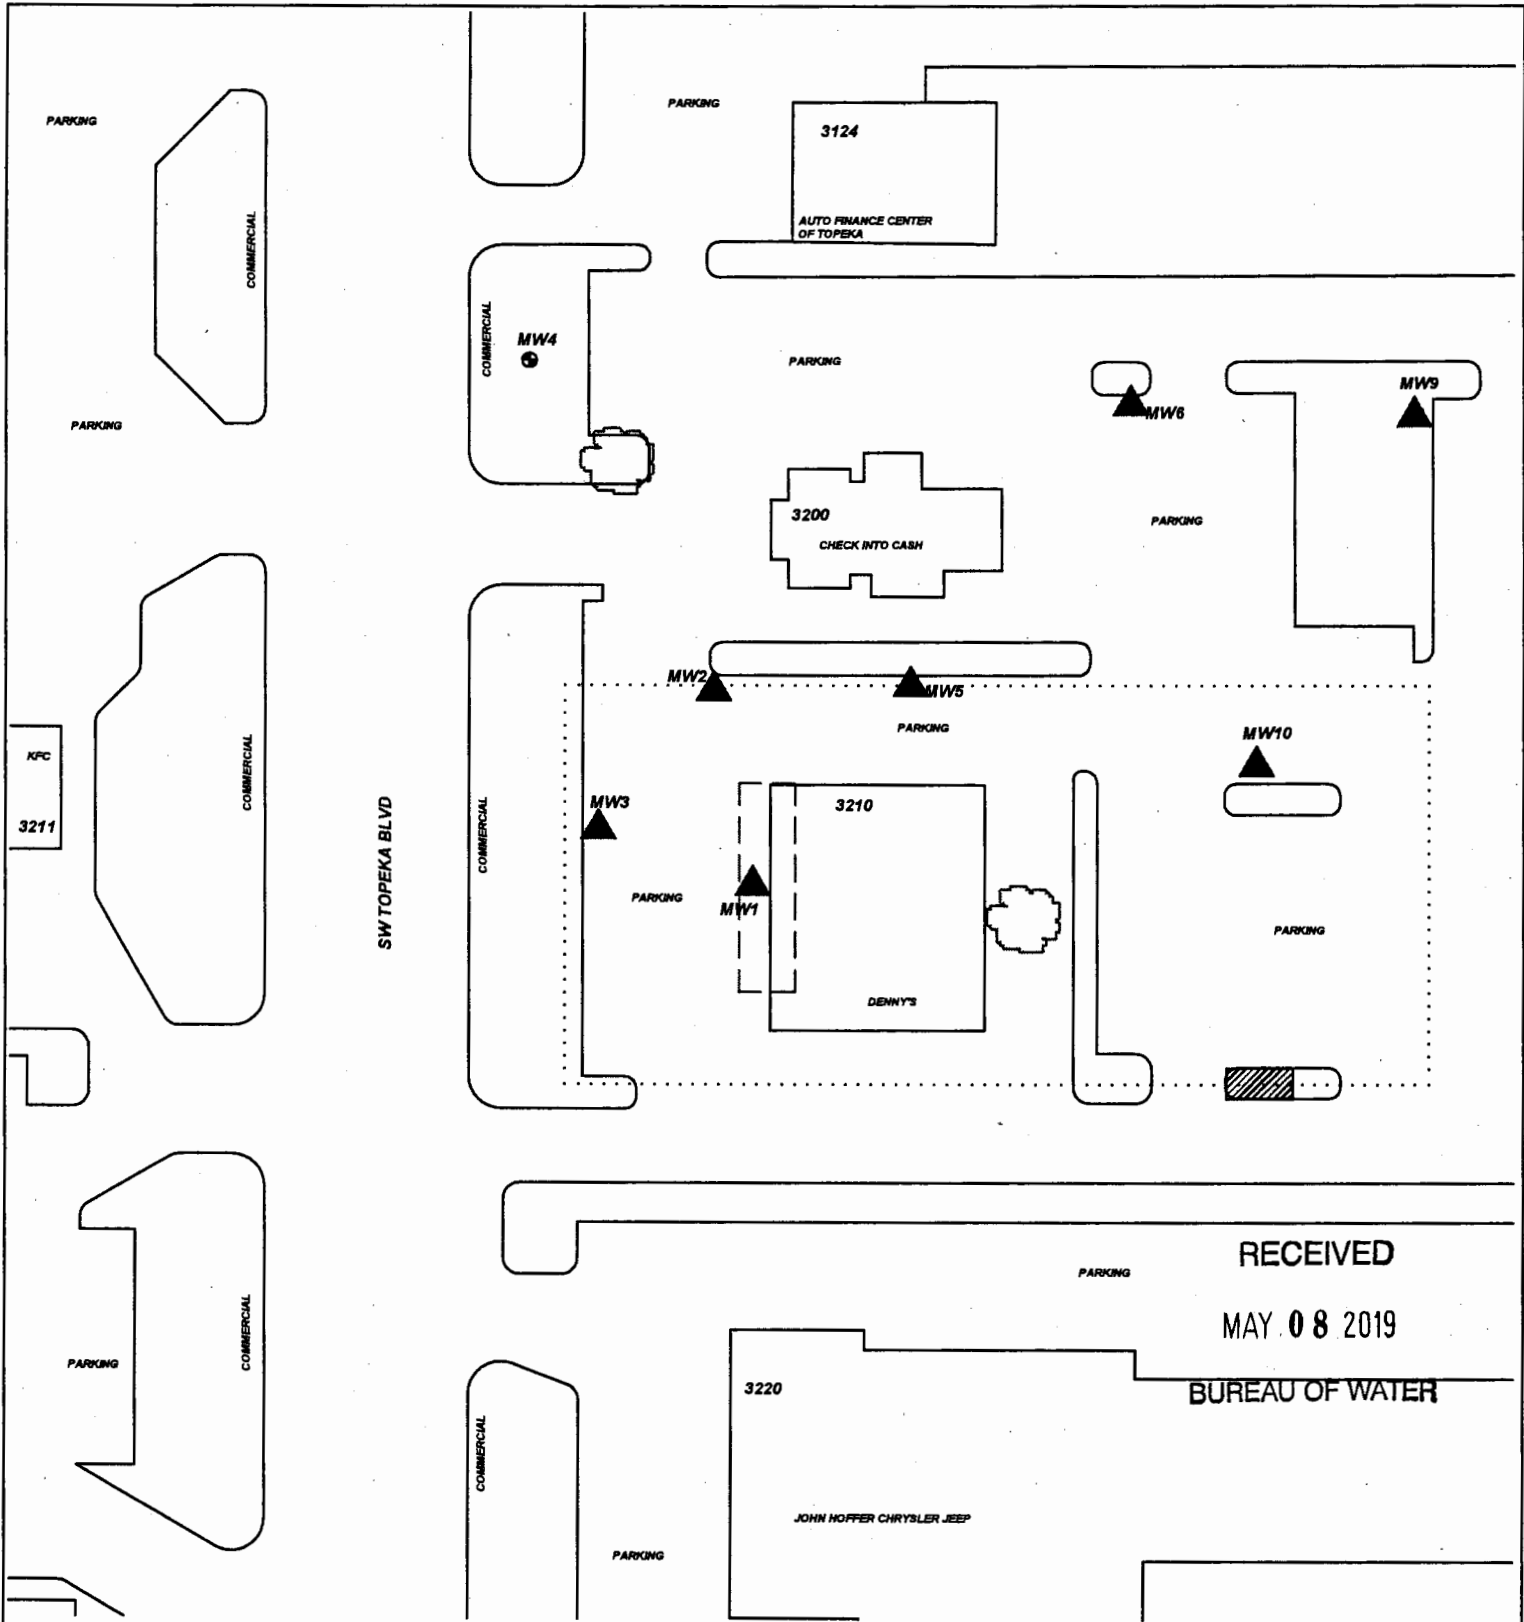

PROJECT: KANSAS DEPT OF TRANSPORTATION
ADDRESS: 3210 SW TOPEKA BLVD
LOCATION: TOPEKA, KS
DRAWN BY: B. STALNAKER **DATE:** 6/4/18
REVISED BY: B. STALNAKER **DATE:** 1/2/19
AEI JOB #: TF248 **KDHE JOB #:** U4-089-01495

TITLE:
ASSOCIATED ENVIRONMENTAL INC.

LEGEND:
 = FORMER UST BASIN AND PUMP ISLAND
 = FORMER UST BASIN
 = MONITORING WELL
 = PLUGGED MONITOR WELL
 = SUBJECT PROPERTY

SCALE: 1" = 100'

NOTES:
 No basements observed within 500'.