


1 LOCATION OF WATER WELL: Fraction SW 1/4 NW 1/4 SW 1/4 NW 1/4 Section Number 18 Township Number T 12 S Range Number 16 E W
 County: Shawnee

Street/Rural Address of Well Location; if unknown, distance & direction from nearest town or intersection: If at owner's address, check here
Global Positioning Systems (GPS) information:
 Latitude: 39.01042 (in decimal degrees)
 Longitude: 95.68663 (in decimal degrees)
 Elevation: 991.84 TOC
 Horizontal Datum: WGS84, NAD83, NAD27
 Collection Method:

2 WATER WELL OWNER: KDOT
 RR#, St. Address, Box #: 3210 SW TOPEKA BLVD
 City, State ZIP Code: TOPEKA, KS 66611
 GPS unit (Make/Model: _____)
 Digital Map/Photo, Topographic Map, Land Survey
 Est. Accuracy: < 3 m, 3-5 m, 5-15 m, > 15 m

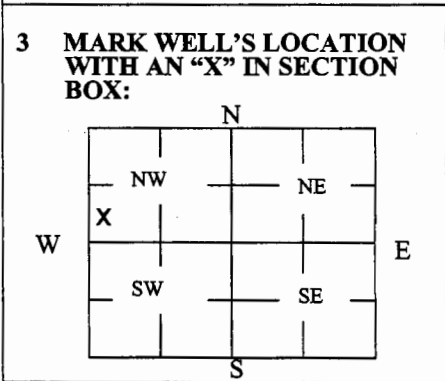

4 DEPTH OF WELL 19.90 ft.
 WELL'S STATIC WATER LEVEL 7.77 ft.
 WELL WAS USED AS:
 Domestic Public Water Supply Dewatering
 Irrigation Oil Field Water Supply Monitoring
 Feedlot Domestic (Lawn & Garden) Injection Well
 Industrial Air Conditioning Other _____
 Was a chemical/bacteriological sample submitted to Department? Yes No


5 TYPE OF BLANK CASING USED:
 Steel RMP (SR) Wrought Fiberglass Other (Specify below) _____
 PVC ABS Asbestos-Cement Concrete Tile
 Blank casing diameter 2 in. Was casing pulled? Yes No If yes, how much 3 ft.
 Casing height above or below land surface 36 in.

6 GROUT PLUG MATERIAL: Neat cement Cement grout Bentonite Other _____
 Grout Plug Intervals: From 3 ft. to 19.90 ft., From _____ ft. to _____ ft., From _____ ft. to _____ ft.
 What is the nearest source of possible contamination:
 Septic tank Seepage pit Fuel storage Other (specify below) _____
 Sewer lines Pit privy Fertilizer storage
 Watertight sewer lines Sewage lagoon Insecticide storage
 Lateral lines Feedyard Abandoned water well Direction from well? EAST
 Cess pool Livestock pens Oil well/Gas well How many feet? 50

FROM	TO	PLUGGING MATERIALS	FROM	TO	PLUGGING MATERIALS
0	0.5	Asphalt			
0.5	3	Compacted silt/clay			
3	19.90	Hydrated Bentonite chips			
					KDOT; U4-089-01495

7 CONTRACTOR'S OR LANDOWNER'S CERTIFICATION: This water well was plugged under my jurisdiction and was completed on (mo/day/year) 4/2/19 and this record is true to the best of my knowledge and belief. Kansas Water Well Contractor's License No. 585. This Water Well Record was completed on (mo/day/year) 4/25/19 under the business name of Associated Environmental, Inc. by (signature) *[Signature]*

Send one white copy to Kansas Department of Health & Environment, Geology Section, 1000 SW Jackson Street, Ste. 420, Topeka, KS 66612-1367. Send one copy to WATER WELL OWNER and retain one for your records.
 Visit us at <http://www.kdheks.gov/waterwell/index.html> Telephone 785-296-5524.

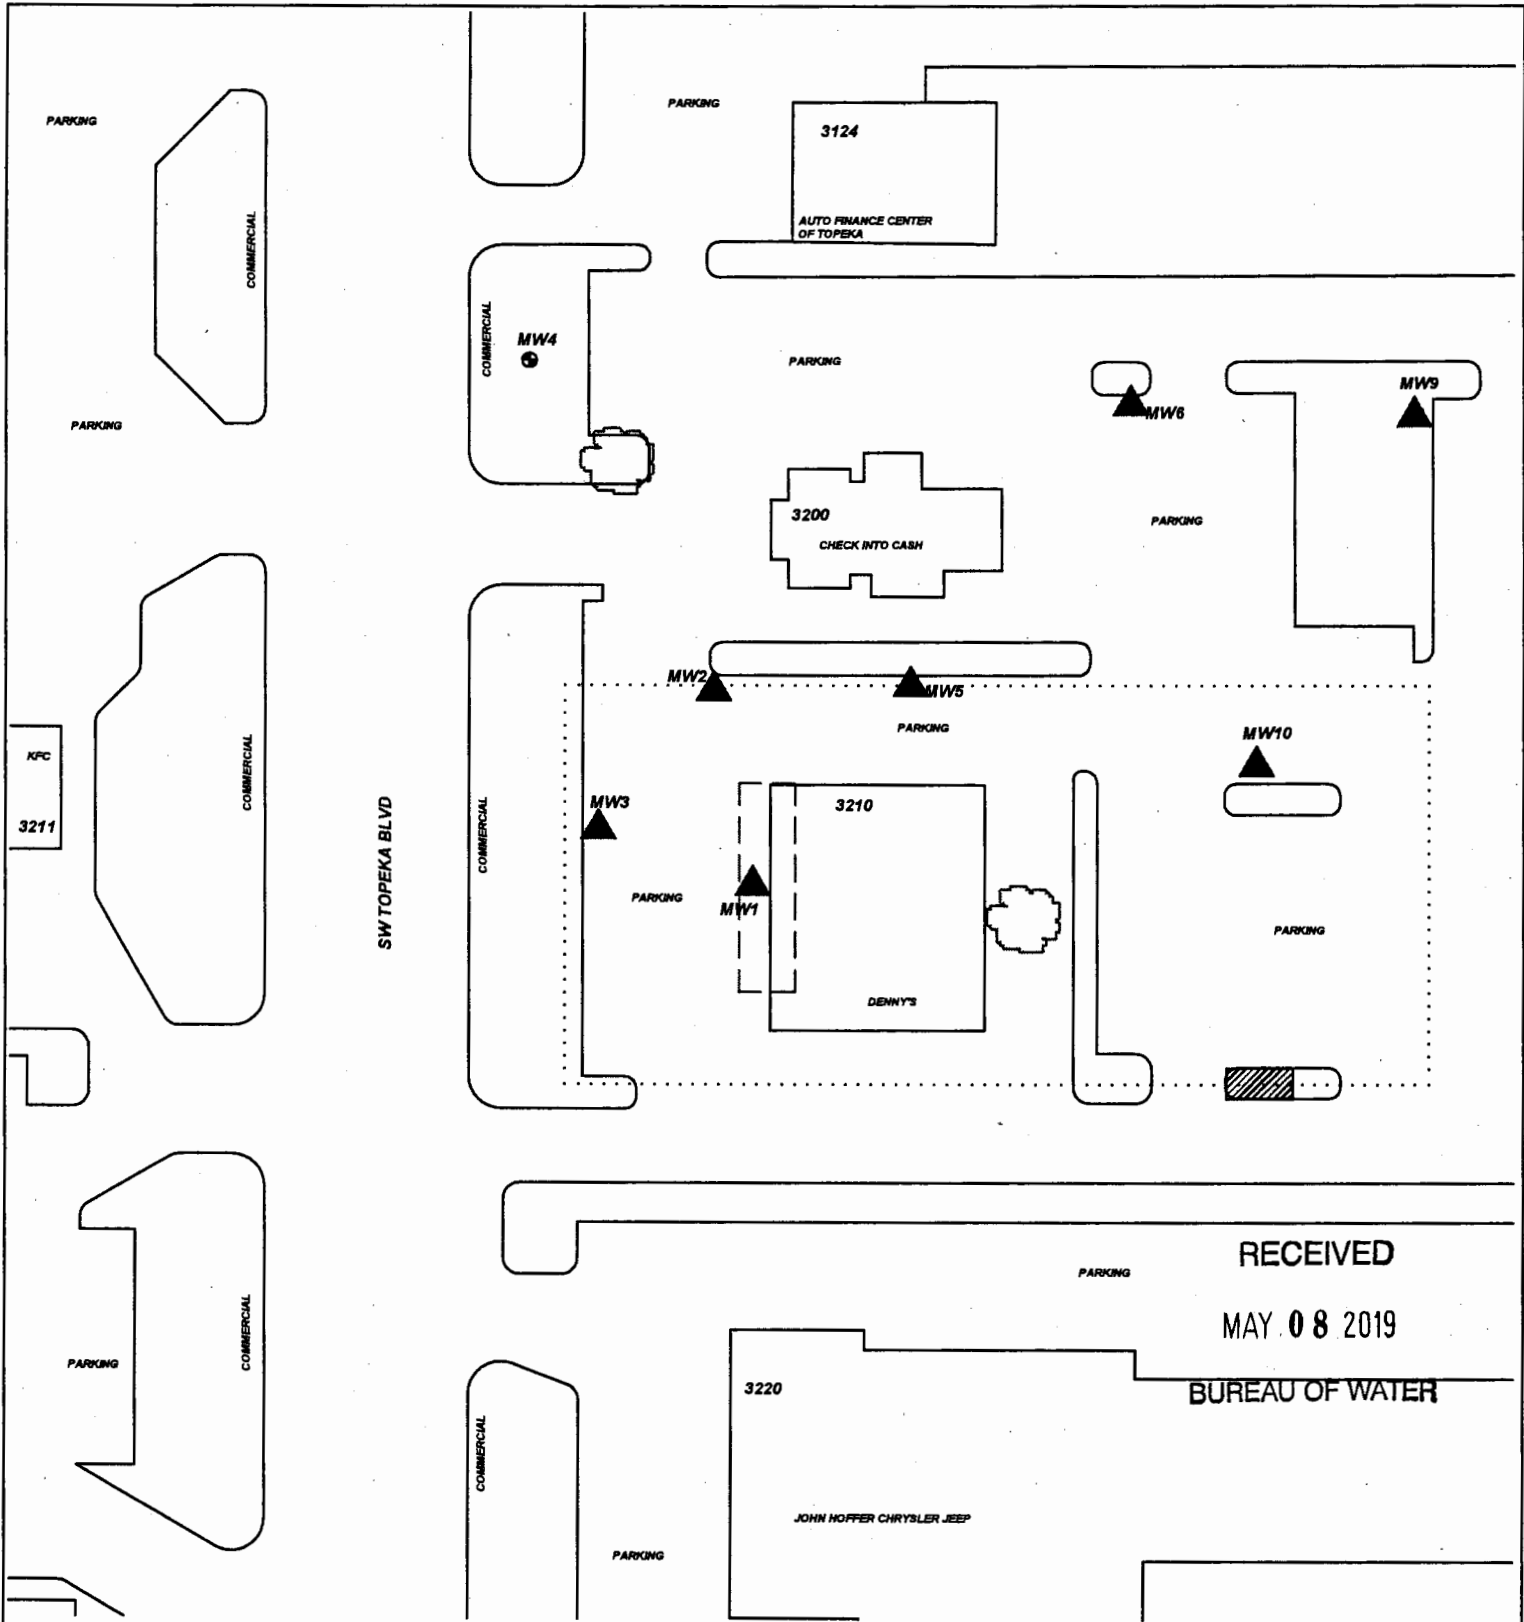

PROJECT: KANSAS DEPT OF TRANSPORTATION
ADDRESS: 3210 SW TOPEKA BLVD
LOCATION: TOPEKA, KS
DRAWN BY: B. STALNAKER **DATE:** 6/4/18
REVISED BY: B. STALNAKER **DATE:** 1/2/19
AEI JOB #: TF248 **KDHE JOB #:** U4-089-01495

TITLE:
ASSOCIATED ENVIRONMENTAL INC.

LEGEND:
 = FORMER UST BASIN AND PUMP ISLAND
 = FORMER UST BASIN
 = MONITORING WELL
 = PLUGGED MONITOR WELL
 = SUBJECT PROPERTY

SCALE: 1" = 100'

NOTES:
 No basements observed within 500'.