

WATER WELL PLUGGING RECORD Form WWC-5P

KSA 82a-1212

ID NO.

1 LOCATION OF WATER WELL: County: Shawnee	Fraction NW ¼ nw ¼ ne ¼ ne ¼	Section Number 13	Township Number 12 T S	Range Number 16 E W
--	---------------------------------	----------------------	---------------------------	------------------------

Street/Rural Address of Well Location; if unknown, distance & direction from nearest town or intersection: If at owner's address, check here ☒ Austin & Mariah Bunyer

5021 SE 29th St.
Tecumseh, KS 66542


Global Positioning Systems (GPS) information:

Latitude: 39.014681 (in decimal degrees)
Longitude: -95.581164 (in decimal degrees)
Elevation: 1004 ft
Horizontal Datum: ☐ WGS84, ☐ NAD83, ☐ NAD27
Collection Method:

2 WATER WELL OWNER: Austin & Mariah Bunyer
RR#, St. Address, Box #: 5021 SE 29th St.
City, State ZIP Code: Tecumseh, KS 66542

☐ GPS unit (Make/Model: _____)
☐ Digital Map/Photo, ☐ Topographic Map, ☐ Land Survey
Est. Accuracy: ☐ < 3 m, ☐ 3-5 m, ☐ 5-15 m, ☐ > 15 m

3 MARK WELL'S LOCATION WITH AN "X" IN SECTION BOX:

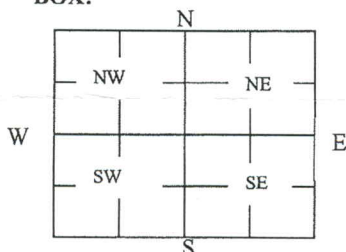

4 DEPTH OF WELL 9 ft.

WELL'S STATIC WATER LEVEL 0.5 ft

WELL WAS USED AS:

- | | | |
|--|---|---|
| <input checked="" type="checkbox"/> Domestic | <input type="checkbox"/> Public Water Supply | <input type="checkbox"/> Dewatering |
| <input type="checkbox"/> Irrigation | <input type="checkbox"/> Oil Field Water Supply | <input type="checkbox"/> Monitoring |
| <input type="checkbox"/> Feedlot | <input type="checkbox"/> Domestic (Lawn & Garden) | <input type="checkbox"/> Injection Well |
| <input type="checkbox"/> Industrial | <input type="checkbox"/> Air Conditioning | <input type="checkbox"/> Other _____ |

Was a chemical/bacteriological sample submitted to Department? Yes ☐ No ☒

5 TYPE OF BLANK CASING USED:

- | | | | | |
|--------------------------------|-----------------------------------|--|--|---|
| <input type="checkbox"/> Steel | <input type="checkbox"/> RMP (SR) | <input type="checkbox"/> Wrought | <input type="checkbox"/> Fiberglass | <input checked="" type="checkbox"/> Other (Specify below) |
| <input type="checkbox"/> PVC | <input type="checkbox"/> ABS | <input type="checkbox"/> Asbestos-Cement | <input type="checkbox"/> Concrete Tile | Brick & mortar |

Blank casing diameter 108 in. Was casing pulled? Yes ☐ No ☒ If yes, how much _____
Casing height above or below land surface 0 in.

6 GROUT PLUG MATERIAL: ☐ Neat cement ☐ Cement grout ☐ Bentonite ☐ Other Flowable Fill

Grout Plug Intervals: From 0 ft. to 9 ft., From _____ ft. to _____ ft., From _____ ft. to _____ ft.

What is the nearest source of possible contamination:

- | | | | |
|---|---|---|--|
| <input checked="" type="checkbox"/> Septic tank | <input type="checkbox"/> Seepage pit | <input type="checkbox"/> Fuel storage | <input type="checkbox"/> Other (specify below) |
| <input type="checkbox"/> Sewer lines | <input type="checkbox"/> Pit privy | <input type="checkbox"/> Fertilizer storage | |
| <input type="checkbox"/> Watertight sewer lines | <input type="checkbox"/> Sewage lagoon | <input type="checkbox"/> Insecticide storage | |
| <input type="checkbox"/> Lateral lines | <input type="checkbox"/> Feedyard | <input type="checkbox"/> Abandoned water well | Direction from well? East |
| <input type="checkbox"/> Cess pool | <input type="checkbox"/> Livestock pens | <input type="checkbox"/> Oil well/Gas well | How many feet? estimated 50 ft |

FROM	TO	PLUGGING MATERIALS	FROM	TO	PLUGGING MATERIALS
0	9	Flowable fill			

7 CONTRACTOR'S OR LANDOWNER'S CERTIFICATION: This water well was plugged under my jurisdiction and was completed on (mo/day/year) 4/16/2020 and this record is true to the best of my knowledge and belief. Kansas Water Well Contractor's License No. _____. This Water Well Record was completed on (mo/day/year) 4/16/2020 under the business name of Shawnee County Health Department by (signature) *Long Run*

Send one white copy to Kansas Department of Health & Environment, Geology Section, 1000 SW Jackson Street, Ste. 420, Topeka, KS 66612-1367. Send one copy to WATER WELL OWNER and retain one for your records.

Visit us at <http://www.kdheks.gov/waterwell/index.html> Telephone 785-296-5524.

ie. cistern functioning as a well, 62
KSA82a-1212

Revised 1/20/2015