


1 LOCATION OF WATER WELL: Fraction NW 1/4 SE 1/4 NE 1/4 Section Number 5 Township Number T 12 S Range Number R 16 E

Distance and direction from nearest town or city street address of well if located within city?

2 WATER WELL OWNER: City of Topeka City Project 1507 Well # 13+85
 RR#, St. Address, Box #: Engineering Dept. Biddle Creek Board of Agriculture, Division of Water Resources
 City, State, ZIP Code: Topeka, Kansas 66601 Application Number:

3 LOCATE WELL'S LOCATION WITH AN "X" IN SECTION BOX:

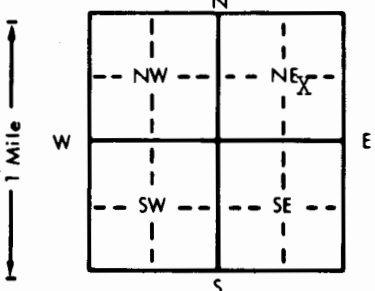

4 DEPTH OF COMPLETED WELL: 40 ft. ELEVATION: ...
 Depth(s) Groundwater Encountered 1. 31 ft. 2. ... ft. 3. ... ft.
 WELL'S STATIC WATER LEVEL: 9'-7" ft. below land surface measured on mo/day/yr 7-20-82

Pump test data: Well water was ... ft. after ... hours pumping ... gpm
 Est. Yield 10 gpm: Well water was ... ft. after ... hours pumping ... gpm
 Bore Hole Diameter 15 in. to 40 ft., and ... in. to ... ft.
 WELL WATER TO BE USED AS:
 5 Public water supply 8 Air conditioning 11 Injection well
 1 Domestic 3 Feedlot 6 Oil field water supply 9 Dewatering 12 Other (Specify below)
 2 Irrigation 4 Industrial 7 Lawn and garden only 10 Observation well
 Was a chemical/bacteriological sample submitted to Department? Yes ... No X; If yes, mo/day/yr sample was submitted
 Water Well Disinfected? Yes ... No X

5 TYPE OF BLANK CASING USED:
 1 Steel 3 RMP (SR) 5 Wrought iron 8 Concrete tile CASING JOINTS: Glued ... Clamped ...
 2 PVC 4 ABS 6 Asbestos-Cement 9 Other (specify below) Welded X
 7 Fiberglass Threaded ...

Blank casing diameter 6 in. to 32 ft., Dia ... in. to ... ft. Dia ... in. to ... ft.
 Casing height above land surface 36 in., weight 19 lbs./ft. Wall thickness or gauge No. 280

TYPE OF SCREEN OR PERFORATION MATERIAL:
 1 Steel 3 Stainless steel 5 Fiberglass 7 PVC 10 Asbestos-cement
 2 Brass 4 Galvanized steel 6 Concrete tile 8 RMP (SR) 11 Other (specify) ...
 9 ABS 12 None used (open hole)

SCREEN OR PERFORATION OPENINGS ARE:
 1 Continuous slot 3 Mill slot 5 Gauzed wrapped 8 Saw cut 11 None (open hole)
 2 Louvered shutter 4 Key punched 6 Wire wrapped 9 Drilled holes
 7 Torch cut 10 Other (specify) ...

SCREEN-PERFORATED INTERVALS: From ... ft. to ... ft. From ... ft. to ... ft.
 GRAVEL PACK INTERVALS: From 28 ft. to 40 ft. From ... ft. to ... ft.

6 GROUT MATERIAL: 1 Neat cement 2 Cement grout 3 Bentonite 4 Other *Not grouted - pulled in few weeks and grouted*
 Grout Intervals: From ... ft. to ... ft., From ... ft. to ... ft., From ... ft. to ... ft.

What is the nearest source of possible contamination?
 1 Septic tank 4 Lateral lines 7 Pit privy 10 Livestock pens 14 Abandoned water well
 2 Sewer lines 5 Cess pool 8 Sewage lagoon 11 Fuel storage 15 Oil well/Gas well
 3 Watertight sewer lines 6 Seepage pit 9 Feedyard 12 Fertilizer storage 16 Other (specify below)
 13 Insecticide storage

Direction from well? ... How many feet?

FROM	TO	LITHOLOGIC LOG	FROM	TO	LITHOLOGIC LOG
0	6	Top Soil			
6	13	Clay, Brown			
13	31	Clay, Brown, Silty			
31	37	Fine Sand, Coarse Sand, Med. Gravel			
37	39	Fine Sand, Coarse Sand, Med. Gravel, Chert 1/4x1/8			
39	40	Shale, Black			
40		Limestone, Grey			
11-8-82		Casing pulled & plugged			
0	31	Cement Grout			
31	40	Gravel			

7 CONTRACTOR'S OR LANDOWNER'S CERTIFICATION: This water well was (1) constructed, (2) reconstructed, or (3) plugged under my jurisdiction and was completed on (mo/day/year) 11-8-82 and this record is true to the best of my knowledge and belief. Kansas Water Well Contractor's License No. 182 This Water Well Record was completed on (mo/day/yr) 12-8-82 under the business name of Strader Drilling Co., Inc. by (signature) Dale Roberson

INSTRUCTIONS: Use typewriter or ball point pen, PLEASE PRESS FIRMLY and PRINT clearly. Please fill in blanks, underline or circle the correct answers. Send top three copies to Kansas Department of Health and Environment, Division of Environment, Environmental Geology Section, Topeka, KS 66620. Send one to WATER WELL OWNER and retain one for your records.

OFFICE USE ONLY

T

12

R

16

EW

SEC

5

NW 1/4

SE 1/4

NE 1/4