


1 LOCATION OF WATER WELL: County: Shawnee Fraction: NW 1/4 SE 1/4 NE 1/4 Section Number: 5 Township Number: T 12 S Range Number: R 16 E

Distance and direction from nearest town or city street address of well if located within city?

2 WATER WELL OWNER: City of Topeka City Project 1507 Well 12+40
 RR#, St. Address, Box #: Engineering Department Biddle Creek Board of Agriculture, Division of Water Resources
 City, State, ZIP Code: Topeka, Kansas 66601 Application Number:

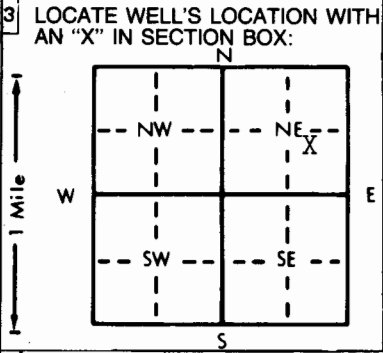

4 DEPTH OF COMPLETED WELL: 27 ft. ELEVATION: ft.
 Depth(s) Groundwater Encountered 1. 14 ft. 2. ft. 3. ft.
 WELL'S STATIC WATER LEVEL 9'-4" ft. below land surface measured on mo/day/yr 7-20-82
 Pump test data: Well water was ft. after hours pumping gpm
 Est. Yield 10 gpm: Well water was ft. after hours pumping gpm
 Bore Hole Diameter: 15 in. to 27 ft., and in. to ft.
 WELL WATER TO BE USED AS:
 5 Public water supply 8 Air conditioning 11 Injection well
 1 Domestic 3 Feedlot 6 Oil field water supply 9 Dewatering 12 Other (Specify below)
 2 Irrigation 4 Industrial 7 Lawn and garden only 10 Observation well
 Was a chemical/bacteriological sample submitted to Department? Yes.....No. X.....; If yes, mo/day/yr sample was submitted
 Water Well Disinfected? Yes No X

5 TYPE OF BLANK CASING USED:
 1 Steel 3 RMP (SR) 5 Wrought iron 8 Concrete tile CASING JOINTS: Glued Clamped
 2 PVC 4 ABS 6 Asbestos-Cement 9 Other (specify below) Welded X
 7 Fiberglass Threaded.....
 Blank casing diameter 6 in. to 11 ft., Dia in. to ft., Dia in. to ft.
 Casing height above land surface 36 in., weight 19 lbs/ft. Wall thickness or gauge No. 280
 TYPE OF SCREEN OR PERFORATION MATERIAL:
 1 Steel 3 Stainless steel 5 Fiberglass 7 PVC 10 Asbestos-cement
 2 Brass 4 Galvanized steel 6 Concrete tile 8 RMP (SR) 11 Other (specify)
 9 ABS 12 None used (open hole)
 SCREEN OR PERFORATION OPENINGS ARE:
 1 Continuous slot 3 Mill slot 5 Gauzed wrapped 8 Saw cut 11 None (open hole)
 2 Louvered shutter 4 Key punched 6 Wire wrapped 9 Drilled holes
 7 Torch cut 10 Other (specify)
 SCREEN-PERFORATED INTERVALS: From 11 ft. to 27 ft., From ft. to ft.
 From ft. to ft., From ft. to ft.
 GRAVEL PACK INTERVALS: From 10 ft. to 27 ft., From ft. to ft.
 From ft. to ft., From ft. to ft.

6 GROUT MATERIAL: X 1 Neat cement 2 Cement grout 3 Bentonite 4 Other Not grouted - pulled in few weeks and grouted
 Grout Intervals: From ft. to ft., From ft. to ft., From ft. to ft.
 What is the nearest source of possible contamination:
 1 Septic tank 4 Lateral lines 7 Pit privy 10 Livestock pens 14 Abandoned water well
 2 Sewer lines 5 Cess pool 8 Sewage lagoon 11 Fuel storage 15 Oil well/Gas well
 3 Watertight sewer lines 6 Seepage pit 9 Feedyard 12 Fertilizer storage 16 Other (specify below)
 13 Insecticide storage
 Direction from well? How many feet?

FROM	TO	LITHOLOGIC LOG	FROM	TO	LITHOLOGIC LOG
0	11	Clay - Brown			
11	26	Clay - Brown, Silty			
26	27	Shale - Grey			
27		Limestone - Grey			
11-8-82		Casing pulled and plugged			
0	17	Cement Grout			
17	27	Gravel			

7 CONTRACTOR'S OR LANDOWNER'S CERTIFICATION: This water well was (1) constructed, (2) reconstructed, or (3) plugged under my jurisdiction and was completed on (mo/day/year) 11-8-82 and this record is true to the best of my knowledge and belief. Kansas Water Well Contractor's License No. 182 This Water Well Record was completed on (mo/day/yr) 12-8-82 under the business name of Strader Drilling Co., Inc. by (signature) Dale Strader

INSTRUCTIONS: Use typewriter or ball point pen, PLEASE PRESS FIRMLY and PRINT clearly. Please fill in blanks, underline or circle the correct answers. Send top three copies to Kansas Department of Health and Environment, Division of Environment, Environmental Geology Section, Topeka, KS 66620. Send one to WATER WELL OWNER and retain one for your records.

OFFICE USE ONLY
T 12
R 16
SEC 5
NW 1/4
SE 1/4
NE 1/4