

LOCATION OF WATER WELL:	Fraction	Section Number	Township Number	Range Number
County: Shawnee	$\frac{1}{4}$ SW $\frac{1}{4}$ SE $\frac{1}{4}$	31	T 12 S	R 16 E W

stance and direction from nearest town or city street address of well if located within city?

WATER WELL OWNER:	U.S. Air Force	
R#, St. Address, Box # :	Forbes Field	Board of Agriculture, Division of Water Resources
ty, State, ZIP Code :	Topeka, KS	Application Number:

LOCATE WELL'S LOCATION WITH AN "X" IN SECTION BOX:

N	
NW	NE
SW	SE
S	

X

4. DEPTH OF COMPLETED WELL: 55 ft. ELEVATION: _____

Depth(s) Groundwater Encountered 1. _____ ft. 2. _____ ft. 3. _____ ft.

WELL'S STATIC WATER LEVEL 8.59 ft. below land surface measured on mo/day/yr _____

Pump test data: Well water was _____ ft. after _____ hours pumping _____ gpm

Est. Yield _____ gpm: Well water was _____ ft. after _____ hours pumping _____ gpm

Bore Hole Diameter... 8 in. to 21.1 ft., and 3.5 in. to 55 ft.

WELL WATER TO BE USED AS:

5 Public water supply	8 Air conditioning	11 Injection well
1 Domestic	3 Feedlot	6 Oil field water supply
2 Irrigation	4 Industrial	9 Dewatering
	7 Lawn and garden only	12 Other (Specify below)

10 Observation well

Was a chemical/bacteriological sample submitted to Department? Yes _____ No X _____; If yes, mo/day/yr sample was submitted _____

Water Well Disinfected? Yes _____ No X _____

TYPE OF BLANK CASING USED:		5 Wrought iron	8 Concrete tile	CASING JOINTS: Glued Clamped	
1 Steel	3 RMP (SR)	6 Asbestos-Cement	9 Other (specify below)	None	Welded
② PVC	4 ABS	7 Fiberglass			Threaded X
Blank casing diameter 4 in. to 21.1 ft., Dia in. to ft., Dia in. to ft.					
Raising height above land surface 24 in., weight lbs./ft. Wall thickness or gauge No. Schedule 80					
TYPE OF SCREEN OR PERFORATION MATERIAL:			7 PVC	10 Asbestos-cement	
1 Steel	3 Stainless steel	5 Fiberglass	8 RMP (SR)	11 Other (specify)	
2 Brass	4 Galvanized steel	6 Concrete tile	9 ABS	⑫ None used (open hole)	
SCREEN OR PERFORATION OPENINGS ARE:			5 Gauzed wrapped	8 Saw cut	11 None (open hole)
1 Continuous slot	3 Mill slot	6 Wire wrapped	9 Drilled holes		
2 Louvered shutter	4 Key punched	7 Torch cut	10 Other (specify) None		
SCREEN-PERFORATED INTERVALS:			From None ft. to ft., From ft. to ft.		
			From ft. to ft., From ft. to ft.		
GRAVEL PACK INTERVALS:			From None ft. to ft., From ft. to ft.		
			From ft. to ft., From ft. to ft.		

GROUT MATERIAL: 1 Neat cement 2 Cement grout 3 Bentonite 4 Other

Interval: From 0 ft. to 21 ft. From ft. to ft. From ft. to ft.


What is the nearest source of possible contamination:

1 Septic tank	4 Lateral lines	7 Pit privy	10 Livestock pens	14 Abandoned water well
2 Sewer lines	5 Cess pool	8 Sewage lagoon	11 Fuel storage	15 Oil well/Gas well
3 Watertight sewer lines	6 Seepage pit	9 Feedyard	12 Fertilizer storage	16 Other (specify below)
			13 Insecticide storage	
Direction from well?			How many feet?	

[illegible]

CONTRACTOR'S OR LANDOWNER'S CERTIFICATION: This water well was (1) constructed, (2) reconstructed, or (3) plugged under my jurisdiction and was completed on (mo/day/year) 12/27/84 and this record is true to the best of my knowledge and belief. Kansas Water Well Contractor's License No. 416 This Water Well Record was completed on (mo/day/yr) 1/5/85 under the business name of Terracon Consultants, Inc. by (signature) [Signature]

INSTRUCTIONS: Use typewriter or ball point pen, PLEASE PRESS FIRMLY and PRINT clearly. Please fill in blanks, underline or circle the correct answers. Send top three copies to Kansas Department of Health and Environment, Division of Environment, Environmental Geology Section, Topeka, KS 66620. Send one to WATER WELL OWNER and retain one for your records.

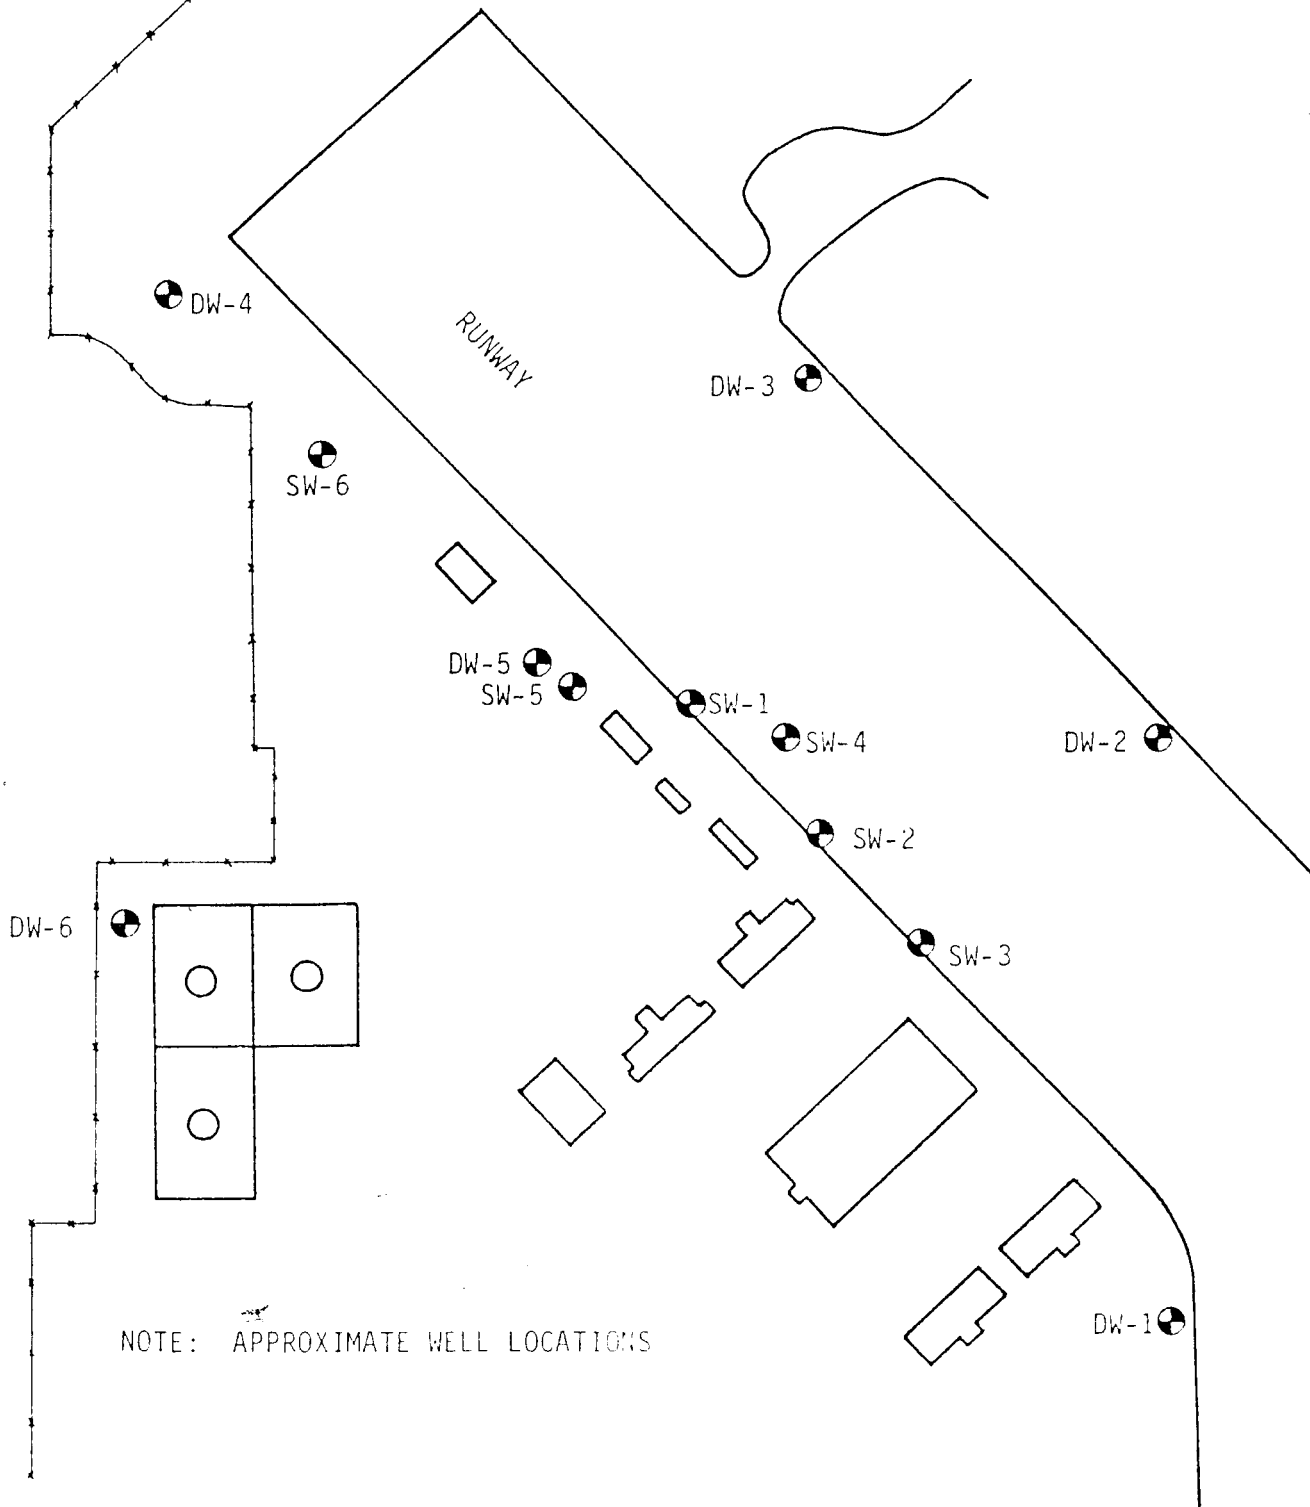

SW-SHALLOW WELLS
DW-ANTICIPATED WELLS

LOCATION DIAGRAM
MONITORING WELLS
FORBES FIELD ANG BASE
TOPEKA, KANSAS



Terracon Consultants, Inc.
Cedar Falls Cedar Rapids Davenport Des Moines, IA
Kansas City Wichita, KS
Oklahoma City Tulsa, OK

JME	NTS	1-16-85	284784
-----	-----	---------	--------