


SW-2 WATER WELL RECORD Form WWC-5 KSA 82a-1212
 LOCATION OF WATER WELL: County: Shawnee Fraction: $\frac{1}{4}$ NE $\frac{1}{4}$ SW $\frac{1}{4}$ Section Number: 31 Township Number: T 12 S Range Number: R 16 EW
 distance and direction from nearest town or city street address of well if located within city?

WATER WELL OWNER: U.S. Air Force
 R#, St. Address, Box #: Forbes Field Board of Agriculture, Division of Water Resources
 City, State, ZIP Code: Topeka, KS Application Number:

LOCATE WELL'S LOCATION WITH AN "X" IN SECTION BOX:

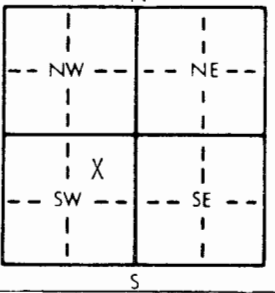

DEPTH OF COMPLETED WELL: 8.5 ft. ELEVATION:
 Depth(s) Groundwater Encountered 1. 7.7 ft. 2. ft. 3. ft.
 WELL'S STATIC WATER LEVEL: 2.62 ft. below land surface measured on mo/day/yr
 Pump test data: Well water was ft. after hours pumping gpm
 Est. Yield gpm: Well water was ft. after hours pumping gpm
 Bore Hole Diameter: 7 in. to 8.5 ft., and in. to ft.
 WELL WATER TO BE USED AS:
 5 Public water supply 8 Air conditioning 11 Injection well
 1 Domestic 3 Feedlot 6 Oil field water supply 9 Dewatering 12 Other (Specify below)
 2 Irrigation 4 Industrial 7 Lawn and garden only 10 Observation well
 Was a chemical/bacteriological sample submitted to Department? Yes No X; if yes, mo/day/yr sample was submitted
 Water Well Disinfected? Yes No X

TYPE OF CASING USED:
 1 Steel 3 RMP (SR) 5 Wrought iron 8 Concrete tile CASING JOINTS: Glued Clamped
 2 PVC 4 ABS 6 Asbestos-Cement 9 Other (specify below) Welded
 7 Fiberglass Threaded X
 Blank casing diameter: 2 in. to 3.5 ft., Dia in. to ft., Dia in. to ft.
 Casing height above land surface: 24 in., weight lbs./ft. Wall thickness or gauge No. Sch40
 TYPE OF SCREEN OR PERFORATION MATERIAL:
 1 Steel 3 Stainless steel 5 Fiberglass 8 RMP (SR) 10 Asbestos-cement
 2 Brass 4 Galvanized steel 6 Concrete tile 9 ABS 11 Other (specify)
 12 None used (open hole)


SCREEN OR PERFORATION OPENINGS ARE:
 1 Continuous slot 3 Mill slot 5 Gauzed wrapped 8 Saw cut 11 None (open hole)
 2 Louvered shutter 4 Key punched 6 Wire wrapped 9 Drilled holes
 7 Torch cut 10 Other (specify)
 SCREEN-PERFORATED INTERVALS: From 8.5 ft. to 3.5 ft., From ft. to ft.
 From ft. to ft., From ft. to ft.
 GRAVEL PACK INTERVALS: From 8.5 ft. to 3.0 ft., From ft. to ft.
 From ft. to ft., From ft. to ft.

GRAVEL PACK MATERIAL: 1 Neat cement 2 Cement grout 3 Bentonite 4 Other
 Grout Intervals: From 2.0 ft. to Surface ft., From ft. to ft., From ft. to ft.
 What is the nearest source of possible contamination:
 1 Septic tank 4 Lateral lines 7 Pit privy 10 Livestock pens 14 Abandoned water well
 2 Sewer lines 5 Cess pool 8 Sewage lagoon 11 Fuel storage 15 Oil well/Gas well
 3 Watertight sewer lines 6 Seepage pit 9 Feedyard 12 Fertilizer storage 16 Other (specify below)
 13 Insecticide storage
 Direction from well? How many feet?

FROM	TO	LITHOLOGIC LOG	FROM	TO	LITHOLOGIC LOG
0.0	1.0	Topsoil			
1.0	7.0	Clay Fill Material			
7.0	8.5	Clay			

CONTRACTOR'S OR LANDOWNER'S CERTIFICATION: This water well was 1 constructed, (2) reconstructed, or (3) plugged under my jurisdiction and was completed on (mo/day/year) 12/28/84 and this record is true to the best of my knowledge and belief. Kansas Water Well Contractor's License No. 416 This Water Well Record was completed on (mo/day/year) 1/5/85 under the business name of Terracon Consultants, Inc. by (signature)

INSTRUCTIONS: Use typewriter or ball point pen, PLEASE PRESS FIRMLY and PRINT clearly. Please fill in blanks, underline or circle the correct answers. Send top three copies to Kansas Department of Health and Environment, Division of Environment, Environmental Geology Section, Topeka, KS 66620. Send one to WATER WELL OWNER and retain one for your records.

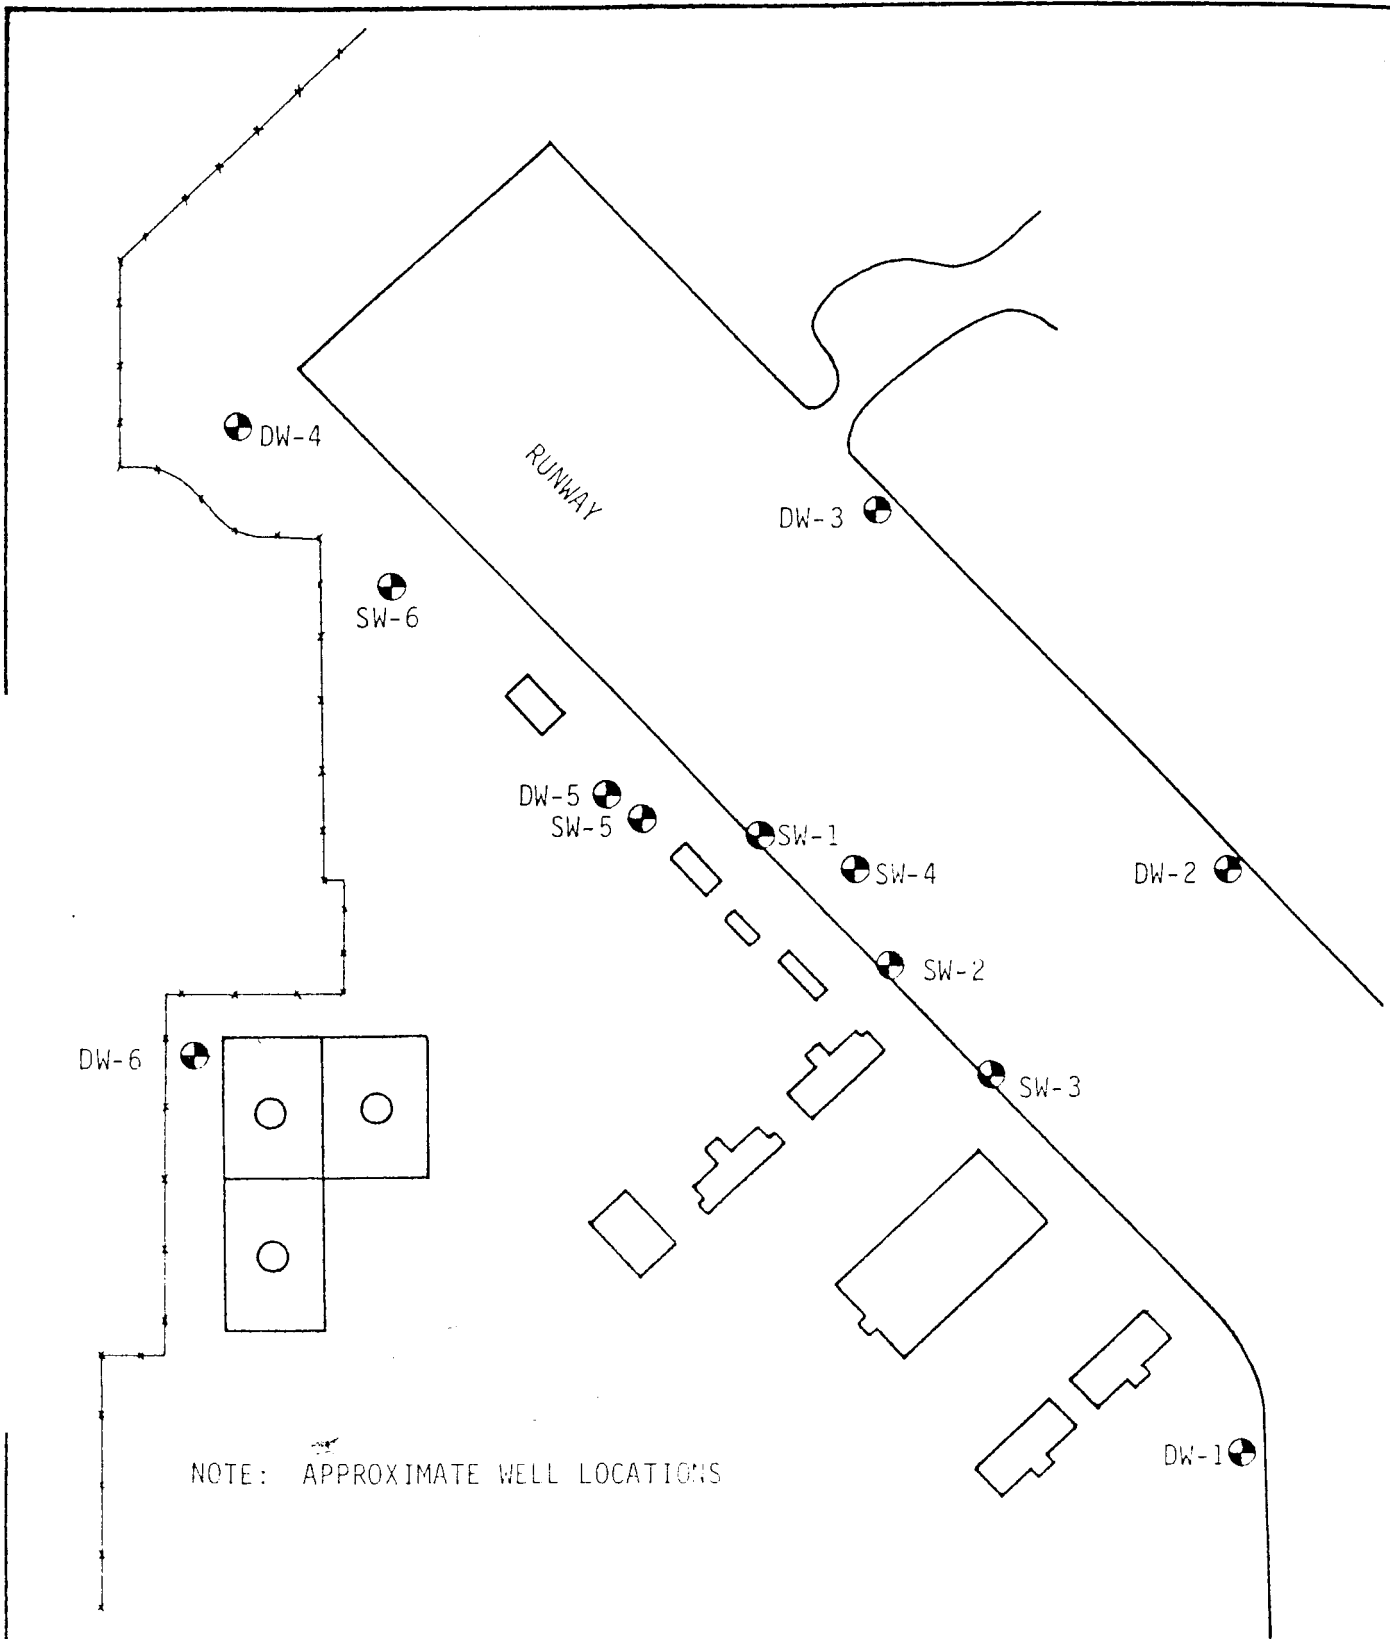

NOTE: APPROXIMATE WELL LOCATIONS

SW-SHALLOW WELLS
 DW-ANTICIPATED WELLS

LOCATION DIAGRAM
 MONITORING WELLS
 FORBES FIELD ANG BASE
 TOPEKA, KANSAS



Terracon Consultants, Inc.
 Cedar Falls Cedar Rapids Davenport Des Moines, IA
 Kansas City Wichita, KS
 Oklahoma City Tulsa, OK

JME	NTS	1-16-85	284784
-----	-----	---------	--------