


Distance and direction from nearest town or city street address of well if located within city?

LOCATE WELL'S LOCATION WITH AN "X" IN SECTION BOX: 4 DEPTH OF COMPLETED WELL: 50 ft. ELEVATION: _____

INSTRUCTIONS: Use typewriter or ball point pen, PLEASE PRESS FIRMLY and PRINT clearly. Please fill in blanks, underline or circle the correct answers. Send top three copies to Kansas Department of Health and Environment, Division of Environment, Environmental Geology Section, Topeka, KS 66620. Send one to WATER WELL OWNER and retain one for your records.

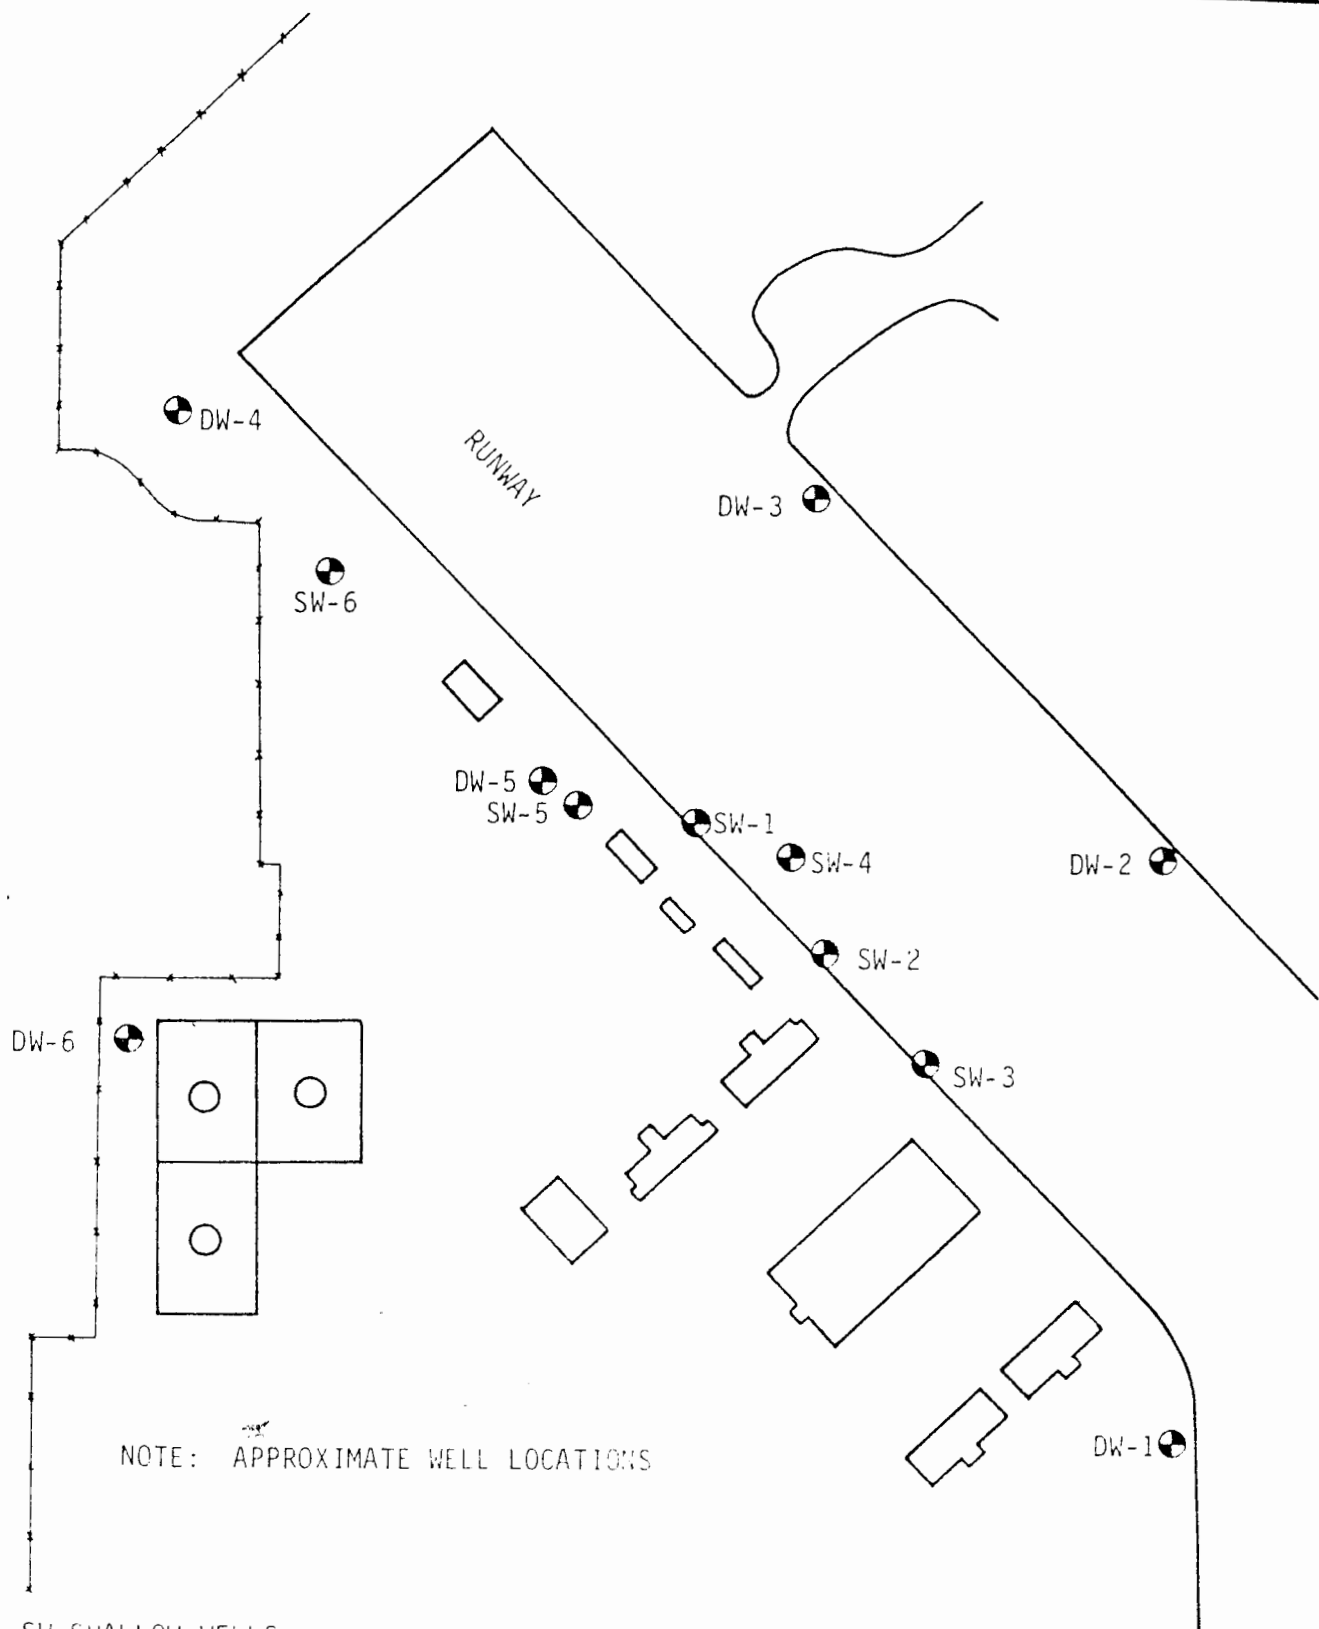

LOCATION DIAGRAM
MONITORING WELLS
FORBES FIELD ANG BASE
TOPEKA, KANSAS



Terracon Consultants, Inc.
Cedar Falls Cedar Rapids Davenport Des Moines, IA
Kansas City Wichita, KS
Oklahoma City Tulsa, OK

JME

NTS

1-16-85

284784