


USE TYPEWRITER OR BALL POINT PEN-PRESS FIRMLY, PRINT CLEARLY.

WATER WELL RECORD
KSA 82a-1201-1215

Kansas Department of Health and Environment-Division of Environment
(Water well Contractors)
Topeka, Kansas 66620

1. Location of well: County Shawnee Fraction 1/4 NW 1/4 NW 1/4 Section number 33 Township number T 125 S R 16 E Range number E/W

2. Distance and direction from nearest town or city: 2 mi North
Street address of well location if in city: West of Perryton
3. Owner of well: Ray Hastings
R.R. or street: RR 1 Box 62
City, state, zip code: Perryton, Kansas

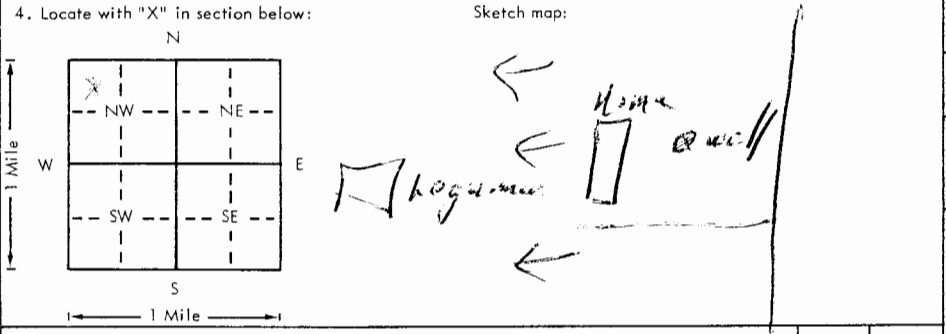

6. Bore hole dia. 5 in. Completion date 7-26-78
Well depth 27 ft.
7. Cable tool Rotary Driven Dug
 Hollow rod Jetted Bored Reverse rotary
8. Use: Domestic Public supply Industry
 Irrigation Air conditioning Stock
 Lawn Oil field water Other
9. Casing: Material PVC Height: Above or below
Threaded Welded Surface 12 in.
RMP PVC Weight lbs./ft.
Dia. 5 in. to 27 ft. depth Wall Thickness: inches or
Dia. in. to ft. depth gage No. 200

5. Type and color of material

	From	To
Top Soil	0	2
Clay yellow	2	9
Clay very thin ^{little sand}	9	14
Lime stone Hard	14	27

10. Screen: Manufacturer's name Sunflow
Type RMP Dia. 5 11
Slot/gauze #30 Length 10
Set between 11 ft. and 27 ft.
 ft. and ft.
Gravel pack? yes Size range of material 1/8-1/2
11. Static water level: 6 ft. below land surface Date 7-26-78
12. Pumping level below land surfaces:
 ft. after hrs. pumping g.p.m.
 ft. after hrs. pumping g.p.m.
Estimated maximum yield 1/3 g.p.m.
13. Water sample submitted: mo./day/yr.
 Yes No Date
14. Well head completion:
 Pitless adapter 12" Inches above grade
15. Well grouted? yes
With: Neat cement Bentonite Concrete
Depth: From 0 ft. to 10 ft.
16. Nearest source of possible contamination:
ft. 500 Direction East Type Logan
Well disinfected upon completion? Yes No
17. Pump: Not installed
Manufacturer's name
Model number HP Volts
Length of drop pipe ft. capacity g.p.m.
Type:
 Submersible Turbine
 Jet Reciprocating
 Centrifugal Other

18. Elevation: _____
19. Remarks: owner to install cement slab
20. Water well contractor's certification:
This well was drilled under my jurisdiction and this report is true to the best of my knowledge and belief.
Business name Robison Drilling 316 License No.
Address Perry KS
Signed Jack Robison Date 9-27-78
Authorized representative

L 2
R 16
S 33
1/4 NW 1/4