

USE TYPEWRITER OR BALL POINT PEN-PRESS FIRMLY, PRINT CLEARLY.


WATER WELL RECORD  
KSA 82a-1201-1215

T R EW sec 1/4 1/4 1/4 No.

Kansas State Dept. Of Health  
(Water Well Contractors)  
Forbes-Bldg. 740  
Topeka, Kansas 66620

1 Location of well: County Shawnee Township name NE 1/4 NE 1/4 NW 1/4 Fraction 36 Section number 36 Town number T-12-S Range number R-16-E

Distance and direction from nearest town or city: \_\_\_\_\_  
3 Owner of well: Bledsoe, Darrell  
Street address of well location if in city: \_\_\_\_\_ Address: 5420 Paulen Topeka, Ks.

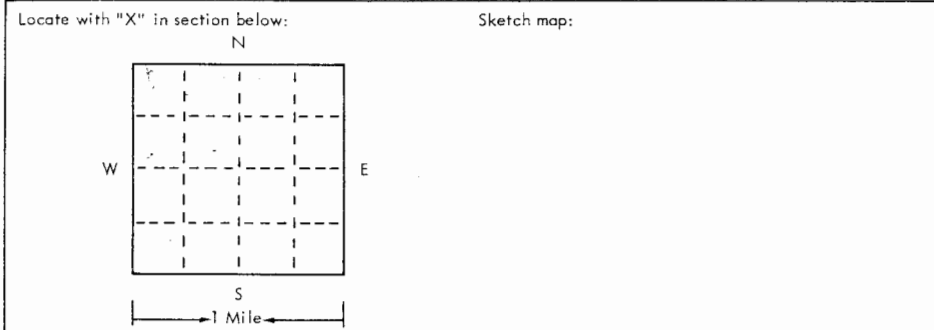

4 Well depth: 74 ft. Date of completion 4/13/75  
Well diameter 10 in.

5  Cable tool  Rotary  Driven  Dug  
 Hollow rod  Jetted  Bored  Reverse rotary

6 Use:  Domestic  Public supply  Industry  
 Irrigation  Air conditioning  Commercial  
 Test well  human only

7 Casing: Material Styrene Height: (above) below  
Threaded  Welded  Surface 15 in.  
Diam. \_\_\_\_\_ Weight \_\_\_\_\_ lbs./ft. \_\_\_\_\_  
6 in. to 54 ft. depth! Drive shoe?  Yes  No  
\_\_\_\_\_ in. to \_\_\_\_\_ ft. depth!

2	Type and color of material	From	To
	Top soil	0	2
	Yellow clay	2	12
	Yellow lime rock	12	14
	Yellow clay and lime gravel	14	19
	White lime	19	27
	Blue shale	35	
	Gray shale with lime rock	27	29
	White lime	29	35
	Blue shale	35	59
	Blue lime	59	69
	Blue shale	69	74
	Total depth 74 feet		
	Show of H2O @ 19-20 feet		

8 Screen: Manufacturer Lowell  
Type Styrene Dia. 6"  
Slot gauge 1/4 Length 20  
Set between 54 ft. and 74 ft.  
Fittings: Gravel pack  Yes  No Size range of material 1/2"

9 Static water level: 12 ft. below land surface Date 4/13/75

10 Pumping level below land surfaces:  
\_\_\_\_\_ ft. after \_\_\_\_\_ hrs. pumping \_\_\_\_\_ g.p.m.  
\_\_\_\_\_ ft. after \_\_\_\_\_ hrs. pumping \_\_\_\_\_ g.p.m.  
Estimated maximum yield 1 g.p.m.

11 Water sample submitted:  
 Yes  No Date \_\_\_\_\_

12 Well head completion: 15  
 Pitless adapter  Inches above grade

13 Well grouted?  Yes  No  
 Neat cement  Bentonite  \_\_\_\_\_  
Depth: From 4 ft. to 12 ft.

14 Nearest source of possible contamination:  
ft. 125 Direction S.E. Type septic  
Well disinfected upon completion?  Yes  No

15 Pump:  Not installed  
Manufacturer's name \_\_\_\_\_  
Model number \_\_\_\_\_ HP \_\_\_\_\_ Volts \_\_\_\_\_  
Length of drop pipe \_\_\_\_\_ ft. capacity \_\_\_\_\_ g.p.m.  
Type:  
 Submersible  Turbine  
 Jet  Reciprocating  
 Centrifugal  Other

16 Remarks: elevation 1074 Customer to install slab  
Test pump by bailer  
Topography:  
 Hill  
 Slope to the east  
 Upland  
 Valley

17 Water well contractor's certification: 148  
This well was drilled under my jurisdiction and this report is true to the best of my knowledge and belief.  
Clumings DRILLING 148  
Business name \_\_\_\_\_ License No. \_\_\_\_\_  
Address RFD 10  
Signed Janette Clumings Date 4/13/75  
Authorized representative