


Distance and direction from nearest town or city street address of well if located within city?  
4000 S. Adams, Topeka, KS

2 WATER WELL OWNER: Josten's  
RF#, St. Address, Box #: 4000 S. Adams Board of Agriculture, Division of Water Resources  
City, State, ZIP Code: Topeka, KS Application Number:

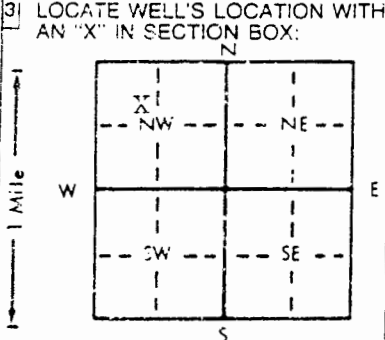

4 DEPTH OF COMPLETED WELL: 25 ft. ELEVATION:  
Depth(s) Groundwater Encountered: 1. 22 ft. 2. ft. 3. ft.  
WELL'S STATIC WATER LEVEL: 16.27 ft. below TOC measured on mo/day/yr 9-22-94  
Pump test data: Well water was ft. after hours pumping gpm  
Est. Yield gpm: Well water was ft. after hours pumping gpm  
Bore Hole Diameter: 8 in. to 25 ft. and in. to ft.  
WELL WATER TO BE USED AS:  
5 Public water supply 8 Air conditioning 11 Injection well  
1 Domestic 3 Feedlot 6 Oil field water supply 9 Dewatering 12 Other (Specify below)  
2 Irrigation 4 Industrial 7 Lawn and garden only 10 Monitoring well  
Was a chemical/bacteriological sample submitted to Department? Yes No ; if yes, mo/day/yr sample was submitted  
Water Well Disinfected? Yes No

5 TYPE OF BLANK CASING USED:  
1 Steel 3 RMP (SR) 5 Wrought iron 8 Concrete tile CASING JOINTS: Glued Clamped  
2 PVC 4 ABS 6 Asbestos-Cement 9 Other (specify below) Welded  
7 Fiberglass Threaded   
Blank casing diameter: 2 in. to 15 ft. Dia. in. to ft. Dia. in. to ft.  
Casing height above land surface: 0 in., weight lbs./ft. Wall thickness or gauge No. Sched 40  
TYPE OF SCREEN OR PERFORATION MATERIAL:  
1 Steel 3 Stainless steel 5 Fiberglass 7 PVC 10 Asbestos-cement  
2 Brass 4 Galvanized steel 6 Concrete tile 8 RMP (SR) 11 Other (specify)  
12 None used (open hole)  
SCREEN OR PERFORATION OPENINGS ARE:  
1 Continuous slot 3 Mill slot 5 Gauzed wrapped 8 Saw cut 11 None (open hole)  
2 Louvered shutter 4 Key punched 6 Wire wrapped 9 Drilled holes  
7 Torch cut 10 Other (specify)  
SCREEN-PERFORATED INTERVALS: From 15 ft. to 25 ft. From ft. to ft.  
GRAVEL PACK INTERVALS: From 13 ft. to 25 ft. From ft. to ft.

6 GROUT MATERIAL: 1 Neat cement 2 Cement grout 3 Bentonite 4 Other  
Grout Intervals: From 0 ft. to 11 ft. From 11 ft. to 13 ft. From ft. to ft.  
What is the nearest source of possible contamination:  
1 Septic tank 4 Lateral lines 7 Pit privy 10 Livestock pens 14 Abandoned water well  
2 Sewer lines 5 Cess pool 8 Sewage lagoon 11 Fuel storage 15 Oil well/Gas well  
3 Watertight sewer lines 6 Seepage pit 9 Feedyard 12 Fertilizer storage 16 Other (specify below)  
13 Insecticide storage Unknown

Direction from well? How many feet?

FROM	TO	LITHOLOGIC LOG	FROM	TO	PLUGGING INTERVALS
0	3	Siltstone - Gray			
3	6	Siltstone - Brown - Orange			
6	8.5	Siltstone - Gray			
8.5	18.5	Siltstone - Lt. Brown - Tan			
18.5	22	Siltstone - Tan - Gray			
22	25	Shale - Gray			
					MW1 Flushmount Don Taylor

7 CONTRACTOR'S OR LANDOWNER'S CERTIFICATION: This water well was (1) constructed, (2) reconstructed, or (3) plugged under my jurisdiction and was completed on (mo/day/year) 9-22-94 and this record is true to the best of my knowledge and belief. Kansas Water Well Contractor's License No. 527. This Water Well Record was completed on (mo/day/yr) 10-25-94 under the business name of GeoCore Services Inc. by (signature)