

WATER WELL RECORD Form WWC-5 KSA 82a-1212

LOCATION OF WATER WELL: County: Shawnee Fraction: NE 1/4 NE 1/4 NW 1/4 Section Number: 19 Township Number: T 12 S Range Number: R 16 E


Distance and direction from nearest town or city street address of well if located within city?

141 W. 37th, Topeka, KS.

WATER WELL OWNER: Coastal Mart
 R#., St. Address, Box #: 141 W. 37th
 City, State, ZIP Code: Topeka, KS.

Board of Agriculture, Division of Water Resources
 Application Number:

LOCATE WELL'S LOCATION WITH AN "X" IN SECTION BOX:

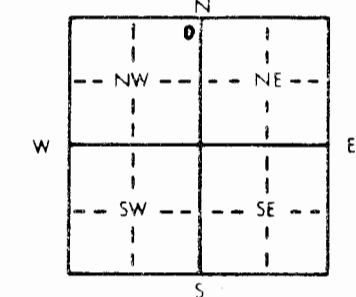

DEPTH OF COMPLETED WELL: 20'0" ft. ELEVATION:

Depth(s) Groundwater Encountered: 1. 3 1/2' ft. 2. _____ ft. 3. _____ ft.

WELL'S STATIC WATER LEVEL: 8.37 ft. below land surface measured on mo/day/yr 1/31/95

Pump test data: Well water was _____ ft. after _____ hours pumping _____ gpm

Est. Yield _____ gpm: Well water was _____ ft. after _____ hours pumping _____ gpm

Bore Hole Diameter: 8 1/2" to 7" in. to _____ ft. and _____ in. to _____ ft.

WELL WATER TO BE USED AS:
 1 Domestic _____ 3 Feedlot _____ 6 Oil field water supply _____ 9 Dewatering _____ 11 Injection well _____
 2 Irrigation _____ 4 Industrial _____ 7 Lawn and garden only _____ 10 Monitoring well _____ 12 Other (Specify below) _____

Was a chemical/bacteriological sample submitted to Department? Yes _____ No X If yes, mo/day/yr sample was submitted _____
 Water Well Disinfected? Yes _____ No X

TYPE OF BLANK CASING USED:
 1 Steel _____ 3 RMP (SR) _____ 5 Wrought iron _____ 8 Concrete tile _____ CASING JOINTS: Glued _____ Clamped _____
 2 PVC _____ 4 ABS _____ 6 Asbestos-Cement _____ 9 Other (specify below) _____ Welded _____
 7 Fiberglass _____ Threaded X

Blank casing diameter: 2.375 in. to 9'8" ft. Dia _____ in. to _____ ft. Dia _____ in. to _____ ft. Dia _____

Casing height above land surface: Flush Mount in. weight _____ lbs./ft. Wall thickness or gauge No. S&W-13

TYPE OF SCREEN OR PERFORATION MATERIAL:
 1 Steel _____ 3 Stainless steel _____ 5 Fiberglass _____ 8 RMP (SR) _____ 10 Asbestos-cement sch 40
 2 Brass _____ 4 Galvanized steel _____ 6 Concrete tile _____ 9 ABS _____ 11 Other (specify) _____
 12 None used (open hole)

SCREEN OR PERFORATION OPENINGS ARE:
 1 Continuous slot _____ 3 Mill slot _____ 5 Gauzed wrapped _____ 8 Saw cut _____ 11 None (open hole) _____
 2 Louvered shutter _____ 4 Key punched _____ 6 Wire wrapped _____ 9 Drilled holes _____
 7 Torch cut _____ 10 Other (specify) _____

SCREEN-PERFORATED INTERVALS: From _____ ft. to _____ ft. From _____ ft. to _____ ft.
 From _____ ft. to _____ ft. From _____ ft. to _____ ft.

GRAVEL PACK INTERVALS: From _____ ft. to _____ ft. From _____ ft. to _____ ft.
 From _____ ft. to _____ ft. From _____ ft. to _____ ft.

GRAVEL PACK INTERVALS: From _____ ft. to _____ ft. From _____ ft. to _____ ft.
 From _____ ft. to _____ ft. From _____ ft. to _____ ft.

GROUT MATERIAL: 1 Neat cement _____ 3 Cement grout _____ 3 Bentonite _____ 4 Other _____
 Grout Intervals: From _____ ft. to _____ ft. From _____ ft. to _____ ft. From _____ ft. to _____ ft.

What is the nearest source of possible contamination:
 1 Septic tank _____ 4 Lateral lines _____ 7 Pit privy _____ 10 Livestock pens _____ 14 Abandoned water well _____
 2 Sewer lines _____ 5 Cess pool _____ 8 Sewage lagoon _____ 11 Fuel storage Fueler _____ 15 Oil well/Gas well _____
 3 Watertight sewer lines _____ 6 Seepage pit _____ 9 Feedyard _____ 12 Fertilizer storage _____ 16 Other (specify below) _____
 13 Insecticide storage _____

Direction from well? Southwest How many feet? 100'

FROM _____ TO _____ LITHOLOGIC LOG FROM _____ TO _____ PLUGGING INTERVALS

FROM	TO	LITHOLOGIC LOG	FROM	TO	PLUGGING INTERVALS
0	2	Grass-dk brn silty clay, rich soil, dry to moist, earthy odor.			
2	7	orangish brn silty clay, tight, iron oxides, mottled, no odor, moist.			
7	8	Limestone			
8	20	Gray shale, hard, calcified shale/siltstone layers, mod odor.			

CONTRACTOR'S OR LANDOWNER'S CERTIFICATION: This water well was (1) constructed, (2) reconstructed, or (3) plugged under my jurisdiction and was completed on (mo/day/year) 1-24-95 and this record is true to the best of my knowledge and belief. Kansas

Water Well Contractor's License No. 539 This Water Well Record was completed on (mo/day/yr) 2/6/95
 Under the business name of JB Environmental Drilling by (signature) James Baker

INSTRUCTIONS: Use typewriter or ball point pen. PLEASE PRESS FIRMLY and PRINT clearly. Please fill in blanks, underline or circle the correct answers. Send top three copies to Kansas Department of Health and Environment, Bureau of Water, Topeka, Kansas 66620-0001 Telephone: 313-296-5515 Send one to WATER WELL OWNER and retain one for your records.