


1 LOCATION OF WATER WELL: County: Shawnee Fraction: NE 1/4 NE 1/4 NW 1/4 Section Number: 19 Township Number: T 12 S Range Number: R 16 E
 Distance and direction from nearest town or city street address of well if located within city?
141 W. 37th, Topeka, KS.

2 WATER WELL OWNER: Coastal Mart
 RR#, St. Address, Box #: 141 W. 37th. Board of Agriculture, Division of Water Resources
 City, State, ZIP Code: Topeka, Ks. 6 Application Number:

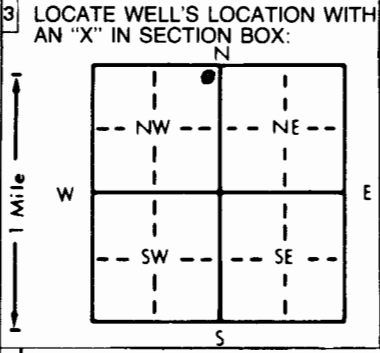

4 DEPTH OF COMPLETED WELL: 17' ft. ELEVATION:
 Depth(s) Groundwater Encountered: 1. 12' ft. 2. ft. 3. ft.
 WELL'S STATIC WATER LEVEL: 9.11 ft. below land surface measured on mo/day/yr 1/31/95
 Pump test data: Well water was ft. after hours pumping gpm
 Est. Yield gpm: Well water was ft. after hours pumping gpm
 Bore Hole Diameter: 8 1/2" - 13" in. to ft., and in. to ft.
 WELL WATER TO BE USED AS:
 1 Domestic 3 Feedlot 6 Oil field water supply 8 Dewatering 12 Other (Specify below)
 2 Irrigation 4 Industrial 7 Lawn and garden only 10 Monitoring well
 Was a chemical/bacteriological sample submitted to Department? Yes No X; If yes, mo/day/yr sample was submitted
 Water Well Disinfected? Yes No

5 TYPE OF BLANK CASING USED:
 1 Steel 3 RMP (SR) 5 Wrought iron 8 Concrete tile CASING JOINTS: Glued Clamped
2 PVC 4 ABS 6 Asbestos-Cement 9 Other (specify below) Welded
 7 Fiberglass Threaded X
 Blank casing diameter 2.375 in. to 6.9" ft., Dia. in. to ft., Dia. in. to ft.
 Casing height above land surface Flush Mount in., weight lbs./ft. Wall thickness or gauge No. SDR-13 Sch 40
 TYPE OF SCREEN OR PERFORATION MATERIAL:
 1 Steel 3 Stainless steel 5 Fiberglass 8 RMP (SR) 11 Other (specify)
 2 Brass 4 Galvanized steel 6 Concrete tile 9 ABS 12 None used (open hole)
 SCREEN OR PERFORATION OPENINGS ARE:
 1 Continuous slot 3 Mill slot 5 Gauzed wrapped 8 Saw cut 11 None (open hole)
 2 Louvered shutter 4 Key punched 6 Wire wrapped 9 Drilled holes
 7 Torch cut 10 Other (specify)
 SCREEN-PERFORATED INTERVALS: From 17' ft. to 7' ft., From ft. to ft.
 GRAVEL PACK INTERVALS: From 17' ft. to 5' ft., From ft. to ft.

6 GROUT MATERIAL:
 Grout Intervals: From 5' ft. to 4' ft., From 4' ft. to 0' ft., From ft. to ft.
 What is the nearest source of possible contamination:
 1 Septic tank 4 Lateral lines 7 Pit privy 11 Fuel storage Famer 15 Oil well/Gas well
 2 Sewer lines 5 Cess pool 8 Sewage lagoon 12 Fertilizer storage 16 Other (specify below)
 3 Watertight sewer lines 6 Seepage pit 9 Feedyard 13 Insecticide storage
 Direction from well? Northwest How many feet? 80'

FROM	TO	LITHOLOGIC LOG	FROM	TO	PLUGGING INTERVALS
0	6	grass-dk-med dk silty clay, dry to moist, few rock frag., roots, earthy odor.			
6	11	Med brn silty mottled clay, iron oxides, earthy odor, dry to moist.			
11	13	Olive-olive yellow mottled silty gravelly clay, moist to wet, slight to mod odor, dk gray mottling.			
13	14	Limestone			
14	16.50	Gray siltstone/shale, dry, hard, no odor.			
16.50	17	Limestone, hard.			

7 CONTRACTOR'S OR LANDOWNER'S CERTIFICATION: This water well was (1) constructed, (2) reconstructed, or (3) plugged under my jurisdiction and was completed on (mo/day/year) 1-24-95 and this record is true to the best of my knowledge and belief. Kansas Water Well Contractor's License No. 539 This Water Well Record was completed on (mo/day/yr) 2-6-95 under the business name of JB Environmental Drilling by (signature) James Bieker