


1 LOCATION OF WATER WELL: County: Shawnee Fraction: NE 1/4 NE 1/4 NW 1/4 Section Number: 19 Township Number: T 12 S Range Number: R 16 E

Distance and direction from nearest town or city street address of well if located within city?  
141 W. 37th, Topeka, KS.

2 WATER WELL OWNER: Coastal Mart  
 RR#, St. Address, Box #: 141 W. 37th. Board of Agriculture, Division of Water Resources  
 City, State, ZIP Code: Topeka, Ks. Application Number:

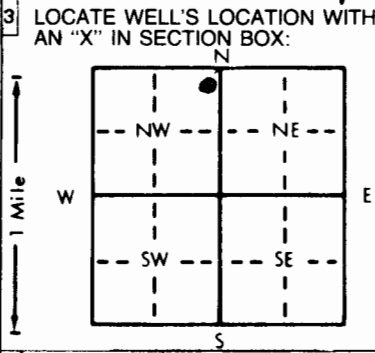

4 DEPTH OF COMPLETED WELL: 18' ft. ELEVATION:  
 Depth(s) Groundwater Encountered 1. 14' ft. 2. ft. 3. ft.  
 WELL'S STATIC WATER LEVEL 11.39 ft. below land surface measured on mo/day/yr 1-31-95  
 Pump test data: Well water was ft. after hours pumping gpm  
 Est. Yield gpm; Well water was ft. after hours pumping gpm  
 Bore Hole Diameter 8 1/2" - 13" in. to ft., and in. to ft.  
 WELL WATER TO BE USED AS:  
 1 Domestic 3 Feedlot 6 Oil field water supply 9 Dewatering 12 Other (Specify below)  
 2 Irrigation 4 Industrial 7 Lawn and garden only 10 Monitoring well  
 Was a chemical/bacteriological sample submitted to Department? Yes No X; If yes, mo/day/yr sample was submitted  
 Water Well Disinfected? Yes No

5 TYPE OF BLANK CASING USED:  
 1 Steel 3 RMP (SR) 5 Wrought iron 8 Concrete tile CASING JOINTS: Glued Clamped  
2 PVC 4 ABS 6 Asbestos-Cement 9 Other (specify below) Welded  
 Blank casing diameter 2.375 in. to 7.6" ft. Dia. in. to ft. Dia. in. to ft. Dia. in. to ft. Dia. in. to ft.  
 Casing height above land surface Flush Mount in., weight lbs./ft. Wall thickness or gauge No. SDR-13  
 TYPE OF SCREEN OR PERFORATION MATERIAL:  
 1 Steel 3 Stainless steel 5 Fiberglass 8 RMP (SR) 11 Other (specify)  
 2 Brass 4 Galvanized steel 6 Concrete tile 9 ABS 12 None used (open hole)  
 SCREEN OR PERFORATION OPENINGS ARE:  
 1 Continuous slot 3 Mill slot 5 Gauzed wrapped 8 Saw cut 11 None (open hole)  
 2 Louvered shutter 4 Key punched 6 Wire wrapped 9 Drilled holes  
 7 Torch cut 10 Other (specify)  
 SCREEN-PERFORATED INTERVALS: From 18' ft. to 8' ft. From ft. to ft. From ft. to ft. From ft. to ft.  
 GRAVEL PACK INTERVALS: From 18' ft. to 6' ft. From ft. to ft. From ft. to ft. From ft. to ft.

6 GROUT MATERIAL:  
 1 Neoprene 2 Cement grout 3 Bentonite 4 Other  
 Grout Intervals: From 6' ft. to 4' ft. From 4' ft. to 0' ft. From ft. to ft. From ft. to ft.  
 What is the nearest source of possible contamination:  
 1 Septic tank 4 Lateral lines 7 Pit privy 11 Fuel storage Founer 15 Oil well/Gas well  
 2 Sewer lines 5 Cess pool 8 Sewage lagoon 12 Fertilizer storage 16 Other (specify below)  
 3 Watertight sewer lines 6 Seepage pit 9 Feedyard 13 Insecticide storage  
 Direction from well? West How many feet? 60'

FROM	TO	LITHOLOGIC LOG	FROM	TO	PLUGGING INTERVALS
0	7	Grass- dk med brn silty clay, root frag., moist, earthy odor.			
7	12	Brn-med brn silty clay, iron oxides, moist, friable, blocky, faint odor.			
12	15	Olive-yellow brn silty gravelly clay, mottled, strong odor, wet at 14'.			
15	16	Limestone, weathered.			
16	18	Gray sandy shale, dry, no odor. Limestone.			

7 CONTRACTOR'S OR LANDOWNER'S CERTIFICATION: This water well was (1) constructed, (2) reconstructed, or (3) plugged under my jurisdiction and was completed on (mo/day/year) 1-23-95 and this record is true to the best of my knowledge and belief. Kansas Water Well Contractor's License No. 539 This Water Well Record was completed on (mo/day/yr) 2-6-95 under the business name of JB Environmental Drilling by (signature) James Bieker

OFFICE USE ONLY  
T  
R  
EW  
SEC  
1/4  
1/4