


KANSAS DEPARTMENT OF TRANSPORTATION


COUNTY *Shawnee* PROJECT NO. *40-89 K2387-01* BRIDGE NO. *22.52*

DESCRIPTION *Tecumseh Creek* STA. *231+63, 18' R+*

GEOLOGIST *L. Myers* VERTICAL SCALE *1" = 10'* DATE *7-8-85*

NW NW 6 12-7E

BIT TYPE & NO.	GEOLOGIC NAME	GEOLOGIC COLUMN	GROUNDWATER ELEVATION	DEPTH	ELEVATION	GEOLOGIC DESCRIPTION AND REMARKS	UNCONFINED COMPRESSION	STANDARD PENETRATION OR CASING DRIVE	
								BLOWS	ELEV.
						879.7			
	<i>Pleistocene</i>			<i>112</i>	<i>868.5</i>	<i>SicL-15 Light Brown</i>	<i>TSC</i>		
			<i>165</i>	<i>862.6</i>			<i>0.9</i>		
			<i>192</i>	<i>859.9</i>			<i>0.6</i>		
				<i>TD</i>					
						<i>C-27 Med. Lt. Gray & Red</i>			

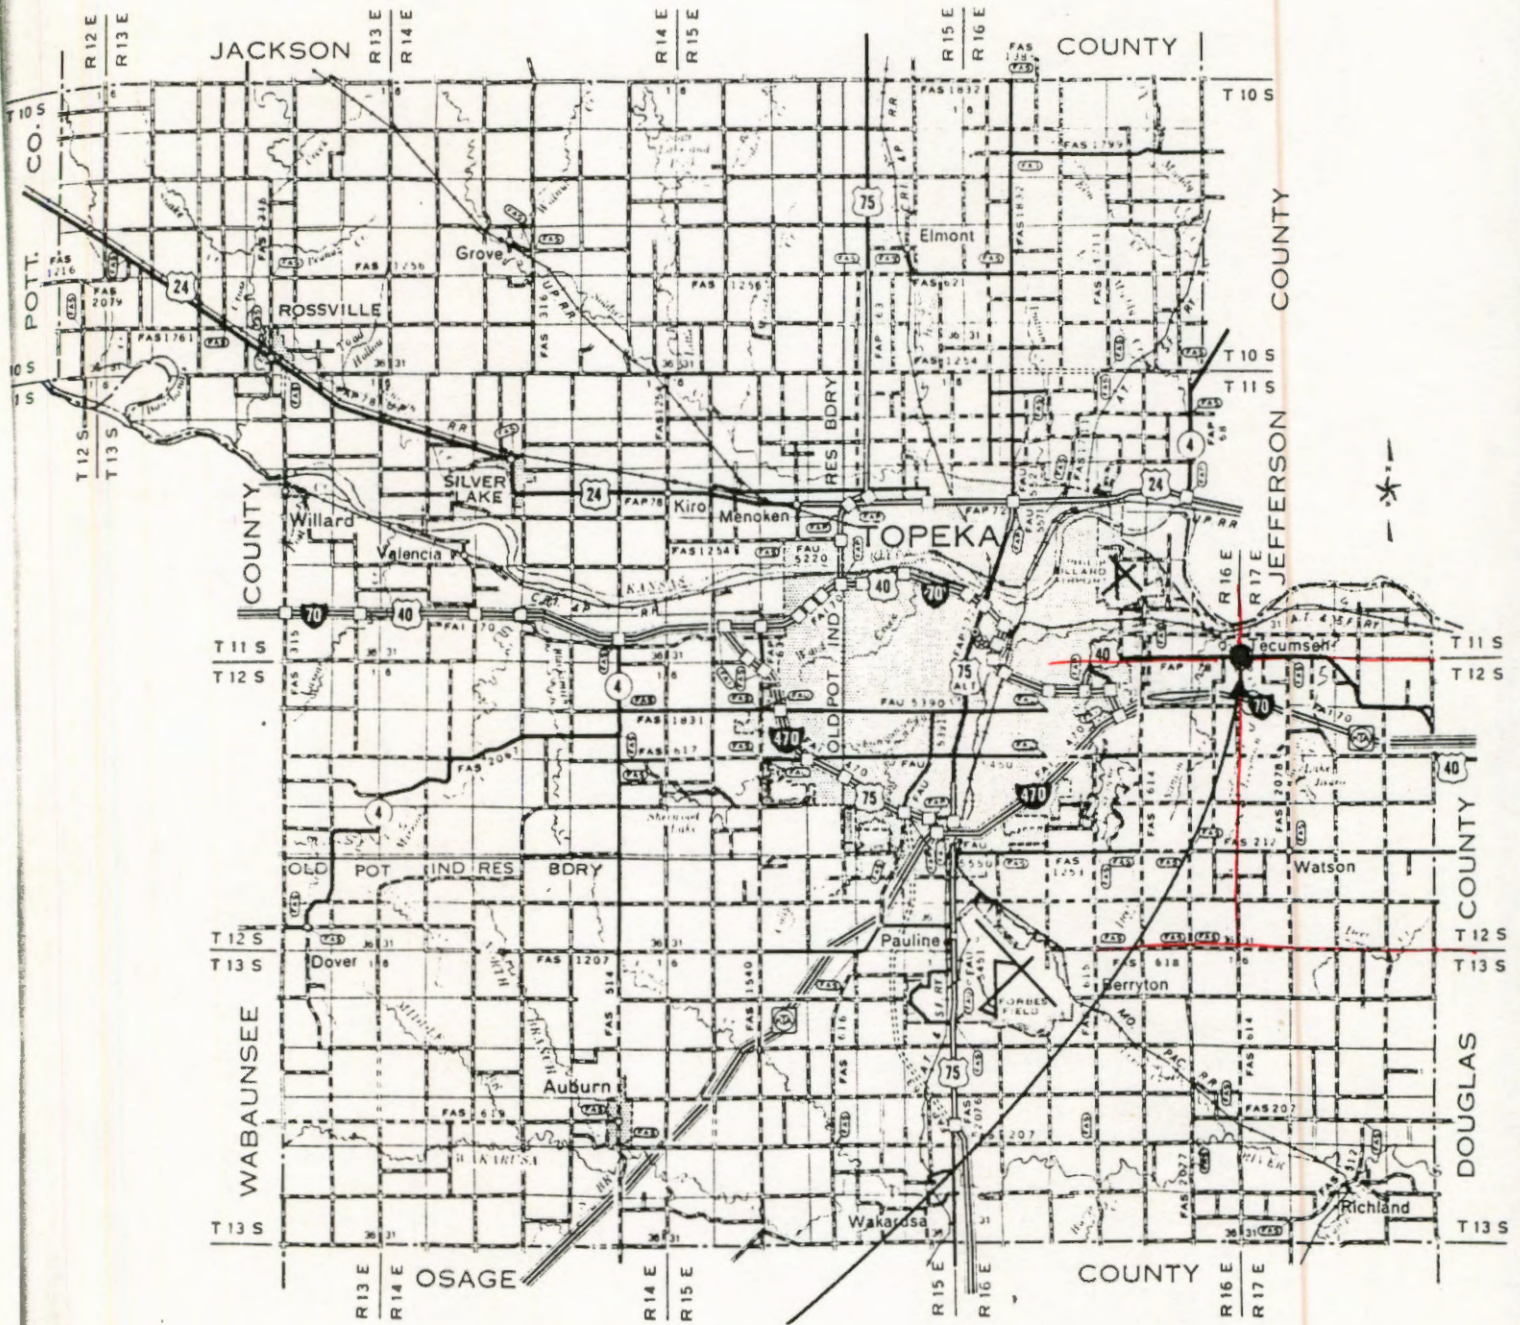

40-89 K-2387-01
 TECUMSEH CREEK
 SHAWNEE COUNTY

Br # 22.52

NW NW NW - 6-12-17E

0-52'

Shawnee

Tecumseh - Leecompton