

County: Shawnee Fraction NW NE NW NW Sec. 29 T 12 S R 17 EW

CORRECTION(S) TO WATER WELL COMPLETION RECORD (WWC-5)

(to rectify lacking or incorrect information)

Owner: Darrell Roseberry

Location was listed as:

Section-Township-Range: 29-12s-17E

Fraction (1/4 1/4 1/4): N/A

Location changed to:

29-12s-17E

NW NE NW NW

Other changes: Initial statements: _____

Changed to: _____

Comments: _____

Verification method: Google Earth, KGS LEOWEB software

initials: DRL date: 4-28-2017

Submitted by: Kansas Geological Survey, Data Resources Library, 1930 Constant Ave., Lawrence, KS 66047-3726

to: Kansas Dept of Health & Environment, Bureau of Water, 1000 SW Jackson, Suite 420, Topeka, KS 66612-1367.


1 LOCATION OF WATER WELL: Fraction $\frac{1}{4}$ $\frac{1}{4}$ $\frac{1}{4}$ Section Number 29 Township Number 12S Range Number 17 E/W
 County: Shawnee

Distance and direction from nearest town or city street address of well if located within city?

6133 SE 45th St. Tecumseh, KS 66542

2 WATER WELL OWNER: Darrell Roseberry
 RR#, St. Address, Box #: 6133 SE 45th St
 City, State ZIP Code: Tecumseh, KS 66542
Global Positioning Systems (decimal degrees, min. of 4 digits)
 Latitude: _____
 Longitude: _____
 Elevation: _____
 Datum: _____
 Data Collection Method: _____

3 MARK WELL'S LOCATION WITH AN "X" IN SECTION BOX:

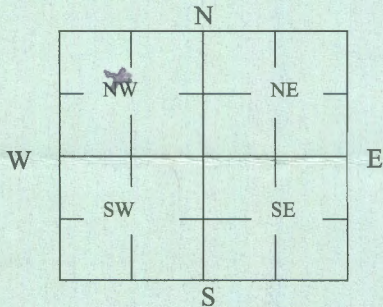

4 DEPTH OF WELL 11 ft.

WELL'S STATIC WATER LEVEL 2 ft

WELL WAS USED AS:

- 1 Domestic
- 2 Irrigation
- 3 Feedlot
- 4 Industrial
- 5 Public Water Supply
- 6 Oil Field Water Supply
- 7 Domestic (Lawn & Garden)
- 8 Air Conditioning
- 9 Dewatering
- 10 Monitoring
- 11 Injection Well
- 12 Other Abandoned

Was a chemical/bacteriological sample submitted to Department? Yes _____ No

5 TYPE OF BLANK CASING USED:

- 1 Steel
- 3 RMP (SR)
- 5 Wrought
- 7 Fiberglass
- 9 Other (Specify below)
- 2 PVC
- 4 ABS
- 6 Asbestos-Cement
- 8 Concrete Tile

Rock lined

Blank casing diameter 132 in. Was casing pulled? Yes _____ No If yes, how much _____
 Casing height above or below land surface 12 in.

6 GROUT PLUG MATERIAL: 1 Neat cement 2 Cement grout 3 Bentonite 4 Other _____

Grout Plug Intervals: From 5' ft. to 4'6" ft., From _____ ft. to _____ ft., From _____ to _____ ft.

What is the nearest source of possible contamination:

- 1 Septic tank
- 2 Sewer lines
- 3 Watertight sewer lines
- 4 Lateral lines
- 5 Cess pool
- 6 Seepage pit
- 7 Pit privy
- 8 Sewage lagoon
- 9 Feedyard
- 10 Livestock pens
- 11 Fuel Storage
- 12 Fertilizer storage
- 13 Insecticide storage
- 14 Abandoned water well
- 15 Oil well/Gas well
- 16 Other (specify below) _____

Direction from well? North
 How many feet? 100+

FROM	TO	PLUGGING MATERIALS	FROM	TO	PLUGGING MATERIALS
<u>11'</u>	<u>5'</u>	<u>Rock & Sand</u>			
<u>5'</u>	<u>4'6"</u>	<u>Bentonite</u>			
<u>4'6"</u>	<u>0</u>	<u>topsoil</u>			

7 CONTRACTOR'S OR LANDOWNER'S CERTIFICATION: This water well was plugged under my jurisdiction and was completed on (mo/day/year) 12-28-16 and this record is true to the best of my knowledge and belief. Kansas Water Well Contractor's License No. _____ This Water Well Record was completed on (mo/day/year) 12-28-16 under the business name of RDR Excavating by (signature) Das Albright

INSTRUCTIONS: Use typewriter or ballpoint pen. Please press firmly and print clearly. Please fill in blanks, underline or circle the correct answers. Send top three copies to Kansas Department of Health and Environment, Bureau of Water, Geology Section, 1000 SW Jackson St., Ste. 420, Topeka, Kansas 66612-1367. Telephone: 785/296-5522. Send one to Water Well Owner and retain one for your records. Visit us at <http://www.kdheks.gov/geo/waterwells>.