


17 E  
17 E

LOCATION OF WATER WELL: Fraction NW 1/4 NW 1/4 SE 1/4 Section Number 5 Township Number T 12 (S) Range Number R 17 E  
 County: Shawnee  
 Distance and direction from nearest town or city street address of well if located within city? 4 E of Topeka

WATER WELL OWNER: Roxie Dreasher  
 RR#, St. Address, Box #: 1201 SE Stanley Rd. Board of Agriculture, Division of Water Resources  
 City, State, ZIP Code: Tecumseh 66542 Application Number:

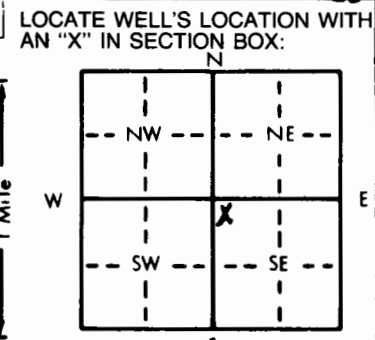

DEPTH OF COMPLETED WELL: 58 ft. ELEVATION: .....  
 Depth(s) Groundwater Encountered 1. 27 ft. 2. .... ft. 3. .... ft.  
 WELL'S STATIC WATER LEVEL 17 ft. below land surface measured on mo/day/yr 7-18-84  
 Pump test data: Well water was ..... ft. after ..... hours pumping ..... gpm  
 Est. Yield 5 gpm: Well water was ..... ft. after ..... hours pumping ..... gpm  
 Bore Hole Diameter 12 in. to ..... ft., and ..... in. to ..... ft.  
 WELL WATER TO BE USED AS: 5 Public water supply 8 Air conditioning 11 Injection well  
 1 Domestic 3 Feedlot 6 Oil field water supply 9 Dewatering 12 Other (Specify below)  
 2 Irrigation 4 Industrial 7 Lawn and garden only 10 Observation well  
 Was a chemical/bacteriological sample submitted to Department? Yes..... No.....; If yes, mo/day/yr sample was submitted  
 Water Well Disinfected? Yes..... No.....

TYPE OF BLANK CASING USED: 5 Wrought iron 8 Concrete tile CASING JOINTS: Glued  Clamped .....  
 1 Steel 3 RMP (SR) 6 Asbestos-Cement 9 Other (specify below) Welded .....  
 2 PVC 4 ABS 7 Fiberglass Threaded .....  
 Blank casing diameter 5 in. to 0-22 ft., Dia 5 in. to 32-53 ft., Dia ..... in. to ..... ft.  
 Casing height above land surface 24 in., weight 282 lbs./ft. Wall thickness or gauge No. 250

TYPE OF SCREEN OR PERFORATION MATERIAL: 7 PVC 10 Asbestos-cement  
 1 Steel 3 Stainless steel 5 Fiberglass 8 RMP (SR) 11 Other (specify) .....  
 2 Brass 4 Galvanized steel 6 Concrete tile 9 ABS 12 None used (open hole)

SCREEN OR PERFORATION OPENINGS ARE: 5 Gauzed wrapped 8 Saw cut 11 None (open hole)  
 1 Continuous slot 3 Mill slot 6 Wire wrapped 9 Drilled holes  
 2 Louvered shutter 4 Key punched 7 Torch cut 10 Other (specify) .....

SCREEN-PERFORATED INTERVALS: From 22 ft. to 32 ft., From ..... ft. to ..... ft.  
 From 53 ft. to 58 ft., From ..... ft. to ..... ft.  
 GRAVEL PACK INTERVALS: From 12 ft. to 58 ft., From ..... ft. to ..... ft.  
 From ..... ft. to ..... ft., From ..... ft. to ..... ft.

GROUT MATERIAL: 1 Neat cement 2 Cement grout 3 Bentonite 4 Other .....  
 Grout Intervals: From 0 ft. to 10 ft., From ..... ft. to ..... ft., From ..... ft. to ..... ft.

What is the nearest source of possible contamination:  
 1 Septic tank 4 Lateral lines 7 Pit privy 10 Livestock pens 14 Abandoned water well  
 2 Sewer lines 5 Cess pool 8 Sewage lagoon 11 Fuel storage 15 Oil well/Gas well  
 3 Watertight sewer lines 6 Seepage pit 9 Feedyard 12 Fertilizer storage 16 Other (specify below)  
 13 Insecticide storage  
 Direction from well? W How many feet? 110

FROM	TO	LITHOLOGIC LOG	FROM	TO	LITHOLOGIC LOG
0	3	Top Soil			
3	22	Clay, brown			
22	25	05 fs - cs			
25	27	17 fs - cs, med gr. Pea gr.			
27	58	2 shaley ls, grey			

CONTRACTOR'S OR LANDOWNER'S CERTIFICATION: This water well was (1) constructed, (2) reconstructed, or (3) plugged under my jurisdiction and was completed on (mo/day/year) 7-18-84 and this record is true to the best of my knowledge and belief. Kansas Water Well Contractor's License No. 182 This Water Well Record was completed on (mo/day/yr) 8-6-84 under the business name of Strader Drly Co., Inc. by signature Dale Askrum

INSTRUCTIONS: Use typewriter or ball point pen, PLEASE PRESS FIRMLY and PRINT clearly. Please fill in blanks, underline or circle the correct answers. Send top three copies to Kansas Department of Health and Environment, Division of Environment, Environmental Geology Section, Topeka, KS 66620. Send one to WATER WELL OWNER and retain one for your records.

OFFICE USE ONLY

T

12

1-1

SEC.

5

11/14





D