

USE TYPEWRITER OR BALL POINT PEN-PRESS FIRMLY, PRINT CLEARLY.

WATER WELL RECORD
KSA 82a-1201-1215

T R EW sec 1/4 1/4 1/4 No.

Kansas State Dept. Of Health
(Water Well Contractors)
Forbes-Bldg. 740
Topeka, Kansas 66620


1 Location of well:	County Shawnee	Township name Tecumseh	Fraction SW 1/4 SW 1/4 SE 1/4	Section number 20	Town number 12S	Range number 17E
---------------------	--------------------------	----------------------------------	---	-----------------------------	---------------------------	----------------------------

Distance and direction from nearest town or city: **1/2 S 7 1/2 E**

Street address of well location if in city: **OF TOPEKA ON 95TH**

3 Owner of well: **Hogue Const OR**

Address: **TOPEKA, KS.**

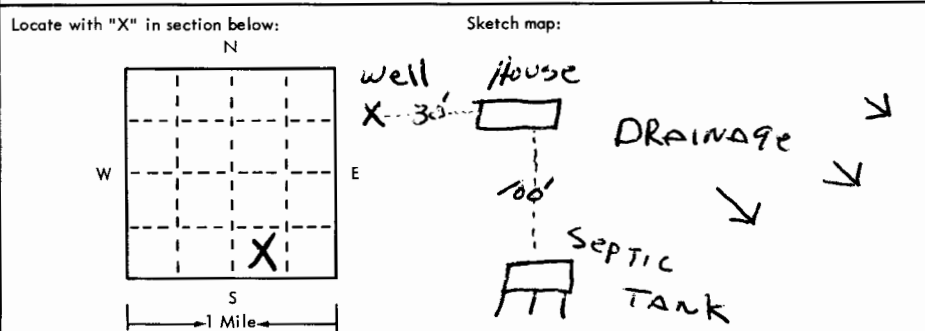

4 Well depth: **60** ft. Date of completion **1-27-76**
Well diameter **10** in.

5 Cable tool Rotary Driven Dug
 Hollow rod Jetted Bored Reverse rotary

6 Use: Domestic Public supply Industry
 Irrigation Air conditioning Commercial
 Test well

7 Casing: Material **PK** Height: **above** below
Threaded Welded Surface **24** in.
Diam. **5** in. to **60** ft. depth Weight **233** lbs./ft.
Drive shoe? Yes No

2	Type and color of material	From	To
	TOP SOIL	0	4
	yellow CLAY (SANDY)	4	25
	SANDSTONE (SOFT)	25	30
	Grey Limestone	30	50
	Blue shale	50	60

8 Screen: Manufacturer **Pump Co**
Type **PVC** Dia. **5"**
Slat/gauze **.030** Length **10**
Set between **25** ft. and **35** ft.
Fittings: **.030 x .080**
Gravel pack Yes No Size range of material

9 Static water level: **20** ft. below land surface Date **1-27-76**

10 Pumping level below land surfaces: **AIR TEST**
ft. after hrs. pumping g.p.m.
ft. after hrs. pumping g.p.m.
Estimated maximum yield **20** g.p.m.

11 Water sample submitted:
 Yes No Date

12 Well head completion: **CAPPED**
 Pitless adapter **24** inches above grade

13 Well grouted? Yes No
 Neat cement Bentonite
Depth: From **0** ft. to **15** ft.

14 Nearest source of possible contamination: **SEPTIC**
ft. **100** Direction **N** Type **TANK**
Well disinfected upon completion? Yes No

15 Pump: Not installed
Manufacturer's name _____
Model number _____ HP _____ Volts _____
Length of drop pipe _____ ft. capacity _____ g.m.p.
Type:
 Submersible Turbine
 Jet Reciprocating
 Centrifugal Other

16 Remarks: elevation **1122** Owner to install slab
Topography: **RM**
 Hill
 Slope
 Upland
 Valley

17 Water well contractor's certification:
This well was drilled under my jurisdiction and this report is true to the best of my knowledge and belief.
Studer Debg Co Inc 182
Business name License No.
Address **RT 1 Holton, KS**
Signed **Dale Anderson** Date **1-31-76**
Authorized representative

12 17E 20 SW SW SE