CORRECTION(S) TO WATER WELL RECORD (WWC-5)
(to rectify lacking or incorrect information)

County: Douglas

Location listed as:	**Location changed to:**
Section-Township-Range: 7-12 S-19	1-12 S-18 E
Fraction (¼ ¼ ¼): NW NW NW	SE NW SE

Other changes: Initial statements:

Changed to:

Comments: Well owner's current address: 2042 E 773 Rd, Lecompton, KS, 66050.

verification method: Well owner's address & area road map, Douglas County online parcel search, sketch map on WWC5, and mapping tool & aerial photos on KGS website. initials: DRL date: 7/19/2012

submitted by: Kansas Geological Survey, Data Resources Library, 1930 Constant Ave., Lawrence, KS 66047-3726
to: Kansas Dept of Health & Environment, Bureau of Water, 1000 SW Jackson, Suite 420, Topeka, KS 66612-1367.

USE TYPEWRITER OR BALL POINT PEN-PRESS FIRMLY, PRINT CLEARLY.

95.35149 39.02774

WATER WELL RECORD
KSA 82a-1201-1215

Lat 7

Kansas Department of Health and Environment-Division of Environment
(Water well Contractors)
Topeka, Kansas 66620

1. Location of well:	County	Fraction	Section number	Township number	Range number
	DOUGLAS	NW 1/4 NW 1/4 NW 1/4	7	T 12 S	R 19 E/W

2. Distance and direction from nearest town or city:
Street address of well location if in city: 3 S.E. LeCompton

3. Owner of well: Roger Bond
R.R. or street: RR
City, state, zip code: LeCompton, KS 66050

4. Locate with "X" in section below:

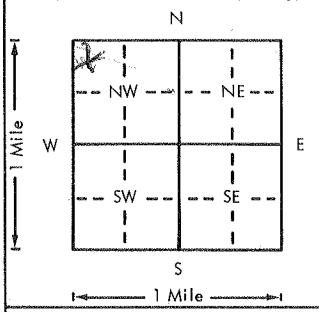

Sketch map:

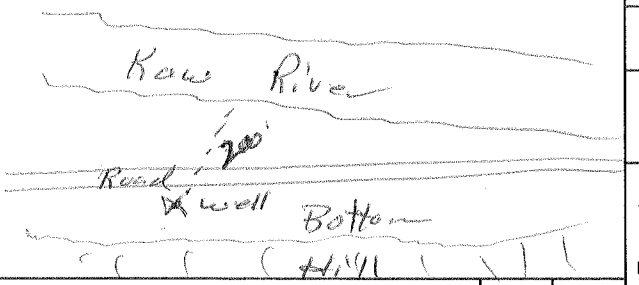

6. Bore hole dia. 8 in. Completion date 8-11-76
Well depth 40 ft.

7. ___ Cable tool ✓ Rotary ___ Driven ___ Dug
___ Hollow rod ___ Jetted ___ Bored ___ Reverse rotary

8. Use: ✓ Domestic ___ Public supply ___ Industry
___ Irrigation ___ Air conditioning ___ Stock
___ Lawn ___ Oil field water ___ Other

9. Casing: Material PVC Height: Above or below
Threaded ___ Welded ___ Surface 24 in.
RMP ___ PVC Glue Weight 2.15 lbs./ft.
Dia. 5 in. to 40 ft. depth Wall Thickness: inches or
Dia. ___ in. to ___ ft. depth gage No. 2.24

10. Screen: Manufacturer's name Pumpco
Type PVC Dia. 5"
Slot/gauze .020 Length 5'
Set between 24 ft. and 29 ft.
___ ft. and ___ ft.
Gravel pack? ✓ Size range of material .13 x .060

11. Static water level: mo./day/yr.
20 ft. below land surface Date 8-11-76

12. Pumping level below land surfaces: Air Test
___ ft. after ___ hrs. pumping ___ g.p.m.
___ ft. after ___ hrs. pumping ___ g.p.m.
Estimated maximum yield 20 g.p.m.

13. Water sample submitted: mo./day/yr.
___ Yes ✓ No Date

14. Well head completion: Capped
___ Pitless adapter 24 Inches above grade

15. Well grouted? ✓
With: ✓ Neat cement ___ Bentonite ___ Concrete
Depth: From 0 ft. to 10 ft.

16. Nearest source of possible contamination: Road Ditch
ft. ___ Direction ___ Type
Well disinfected upon completion? ___ Yes ✓ No

17. Pump: ✓ Not installed
Manufacturer's name
Model number ___ HP ___ Volts ___
Length of drop pipe ___ ft. capacity ___ g.p.m.
Type:
___ Submersible ___ Turbine
___ Jet ___ Reciprocating
___ Centrifugal ___ Other

5. Type and color of material

	From	To
Sandy T. S.	0	5
Br. Silt	5	13
Br. Fine sandy Clay	13	24
Br. Fine Sand	24	26
Br. Med.-Coarse Sand	26	28
Gray Coarse-Pea Gravel	28	29
Yell. Shale	29	33
Gray Shale	33	40

(Use a second sheet if needed)

18. Elevation:

Topography:
___ Hill
___ Slope
___ Upland
✓ Valley

19. Remarks: I WILL PUT A CEMENT SLAB AROUND MY WELL
X Roger Bond

20. Water well contractor's certification:
This well was drilled under my jurisdiction and this report is true to the best of my knowledge and belief.
Stander Drlg Co Inc 182
Business name License No.
Address RT 1 Holton, KS
Signed Dale Carson Date 8-14-76
Authorized representative

T 12 S R 19 E W Sec 7 1/4 1/4 1/4 1/4

Forward the white, blue and pink copies to the Department of Health and Environment

Form WWC-5

MI-1023