

CORRECTION(S) TO WATER WELL RECORD (WWC-5)

(to rectify lacking or incorrect information)

County: Douglas

Location listed as:

Location changed to:

Section-Township-Range: 34-12S

34-12S-19E

Fraction ($\frac{1}{4}$ $\frac{1}{4}$ $\frac{1}{4}$): NE NE NW

NE NE NW

Other changes: Initial statements: well located S of Hwy 40

Changed to: North of Hwy 40

Comments: Call to driller confirmed change

verification method: Written & legal descriptions, city map,
and county map.

initials: DRD date: 3/3/2004


MW-2

1 LOCATION OF WATER WELL: Fraction NE 1/4 NE 1/4 NW 1/4 Section Number 34 Township Number T 12 S Range Number R E/W
 County: Douglas

Distance and direction from nearest town or city street address of well if located within city?
~25' South of Hwy 40 (6th Street)

2 WATER WELL OWNER: HxVee
 RR#, St. Address, Box # : 4000 W. 6th street
 City, State, ZIP Code : Lawrence, KS
 Board of Agriculture, Division of Water Resources
 Application Number:

3 LOCATE WELL'S LOCATION WITH AN "X" IN SECTION BOX: 4 DEPTH OF COMPLETED WELL 20 ft. ELEVATION:

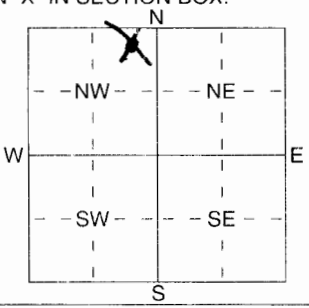

Depth(s) Groundwater Encountered 1 ft. 2 ft. 3 ft.
 WELL'S STATIC WATER LEVEL Dry ft. below land surface measured on mo/day/yr 8-15-03
 Pump test data: Well water was ft. after hours pumping gpm
 Est. Yield gpm: Well water was ft. after hours pumping gpm
 WELL WATER TO BE USED AS:
 1 Domestic 3 Feedlot 5 Public water supply 8 Air conditioning 11 Injection well
 2 Irrigation 4 Industrial 6 Oil field water supply 9 Dewatering 12 Other (Specify below)
 7 Domestic (lawn & garden) 10 Monitoring well
 Was a chemical/bacteriological sample submitted to Department? Yes No; If yes, mo/day/yr sample was submitted
 Water Well Disinfected? Yes No

5 TYPE OF BLANK CASING USED:
 1 Steel 3 RMP (SR) 5 Wrought iron 8 Concrete tile
 2 PVC 4 ABS 6 Asbestos-Cement 9 Other (specify below)
 7 Fiberglass
 CASING JOINTS: Glued Clamped
 Welded
 Threaded Threaded

Blank casing diameter 2 in. to ft., Dia in. to ft., Dia in. to ft.
 Casing height above land surface 0 in., weight lbs./ft. Wall thickness or gauge No. Sch 40

TYPE OF SCREEN OR PERFORATION MATERIAL:
 1 Steel 3 Stainless Steel 5 Fiberglass 7 BVC 10 Asbestos-Cement
 2 Brass 4 Galvanized Steel 6 Concrete tile 8 RMP (SR) 11 Other (Specify)
 9 ABS 12 None used (open hole)

SCREEN OR PERFORATION OPENINGS ARE:
 1 Continuous slot 3 Mill slot 5 Gauzed wrapped 8 Saw cut 11 None (open hole)
 2 Louvered shutter 4 Key punched 6 Wire wrapped 9 Drilled holes
 7 Torch cut 10 Other (specify) ft.

SCREEN-PERFORATED INTERVALS: From 10.0 ft. to 20.0 ft., From ft. to ft.
 GRAVEL PACK INTERVALS: From 9.0 ft. to 20.0 ft., From ft. to ft.

6 GROUT MATERIAL: 1 Neat cement 2 Cement grout 3 Bentonite 4 Other
 Grout Intervals: From ft. to ft., From ft. to ft., From ft. to ft.

What is the nearest source of possible contamination:
 1 Septic tank 4 Lateral lines 7 Pit privy 10 Livestock pens 14 Abandoned water well
 2 Sewer lines 5 Cess pool 8 Sewage lagoon 11 Fuel storage 15 Oil well/Gas well
 3 Watertight sewer lines 6 Seepage pit 9 Feedyard 12 Fertilizer storage 16 Other (specify below)
 13 Insecticide storage
 Direction from well? How many feet?

| FROM | TO | LITHOLOGIC LOG | FROM | TO | PLUGGING INTERVALS |
|------|------|---------------------------|------|----|--------------------|
| 0.0 | 0.5 | Concrete | | | |
| 0.5 | 2.0 | Brn fat clay trace gravel | | | |
| 2.0 | 3.5 | Brn clay | | | |
| 3.5 | 8.0 | Grey shale | | | |
| 8.0 | 20.0 | Weathered Limestone | | | |
| | | | | | |
| | | | | | |
| | | | | | |
| | | | | | |
| | | | | | |
| | | | | | |
| | | | | | |

7 CONTRACTOR'S OR LANDOWNER'S CERTIFICATION: This water well was 1 constructed, (2) reconstructed, or (3) plugged under my jurisdiction and was completed on (mo/day/year) 8-14-03 and this record is true to the best of my knowledge and belief. Kansas Water Well Contractor's Licence No. 708 This Water Well Record was completed on (mo/day/yr) 8-15-03 under the business name of Aquatera Environmental Solutions by (signature) [Signature]