

CORRECTION(S) TO WATER WELL RECORD (WWC-5)

(to rectify lacking or incorrect information)

County: Douglas

Location listed as:

Section-Township-Range: 36-125-19E

Fraction (1/4 1/4 1/4): SE NE NE

Location changed to:

36-125-19E

NW NW SW NW

Other changes: Initial statements: _____

Changed to: _____

Comments: _____

verification method: Wellsite address, city street map, and mapping tool on KGS website.

initials: DRJ date: 9/30/2010


submitted by: Kansas Geological Survey, Data Resources Library, 1930 Constant Ave., Lawrence, KS 66047-3726
to: Kansas Dept of Health & Environment, Bureau of Water, 1000 SW Jackson, Suite 420, Topeka, KS 66612-1367.

MW-5 2412263

WATER WELL RECORD Form WWC-5 KSA 82a-1212

1 LOCATION OF WATER WELL: Fraction SE 1/4 NE 1/4 NE 1/4 Section Number 36 Township Number T 12 S Range Number R 19 E
 County: DOUGLAS
 Distance and direction from nearest town or city street address of well if located within city?
2005 W. 9th LAWRENCE, KS

2 WATER WELL OWNER: TOTAL PIPING
 RR#, St. Address, Box #: 999 18th St., RO. BOX 500 Board of Agriculture, Division of Water Resources
 City, State, ZIP Code: DENVER, CO 80201 Application Number:

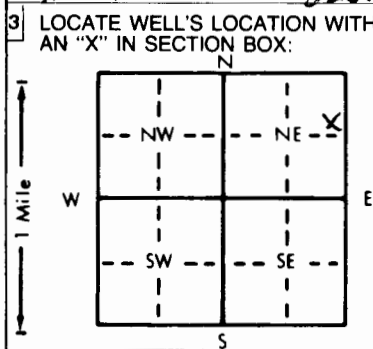

4 DEPTH OF COMPLETED WELL: 15.5 ft. ELEVATION:
 Depth(s) Groundwater Encountered 1. 9.6 ft. 2. ft. 3. ft.
 WELL'S STATIC WATER LEVEL 10.5 ft. below land surface measured on mo/day/yr 4/30/97
 Pump test data: Well water was ft. after hours pumping gpm
 Est. Yield gpm: Well water was ft. after hours pumping gpm
 Bore Hole Diameter 8 in. to ft. and in. to ft.
 WELL WATER TO BE USED AS:
 1 Domestic 3 Feedlot 6 Oil field water supply 9 Dewatering 12 Other (Specify below)
 2 Irrigation 4 Industrial 7 Lawn and garden only 10 Monitoring well MW-5
 Was a chemical/bacteriological sample submitted to Department? Yes No X; If yes, mo/day/yr sample was submitted
 Water Well Disinfected? Yes No X

5 TYPE OF BLANK CASING USED:
 1 Steel 3 RMP (SR) 5 Wrought iron 8 Concrete tile CASING JOINTS: Glued Clamped
3 PVC 4 ABS 7 Fiberglass 9 Other (specify below) Welded
 Threaded PK Flush
 Blank casing diameter 2 in. to 5 ft. Dia. in. to ft. Dia. in. to ft.
 Casing height above land surface: Flush in. weight 703 lbs./ft. Wall thickness or gauge No. Screen 40
 TYPE OF SCREEN OR PERFORATION MATERIAL:
 1 Steel 3 Stainless steel 5 Fiberglass 8 RMP (SR) 10 Asbestos-cement
 2 Brass 4 Galvanized steel 6 Concrete tile 9 ABS 11 Other (specify)
 12 None used (open hole)
 SCREEN OR PERFORATION OPENINGS ARE:
 1 Continuous slot 3 Mill slot 5 Gauzed wrapped 8 Saw cut 11 None (open hole)
 2 Louvered shutter 4 Key punched 6 Wire wrapped 9 Drilled holes
 7 Torch cut 10 Other (specify)
 SCREEN-PERFORATED INTERVALS: From 5 ft. to 15 ft. From ft. to ft.
 From ft. to ft. From ft. to ft.
 GRAVEL PACK INTERVALS: From 3 ft. to 15.5 ft. From ft. to ft.
 From ft. to ft. From ft. to ft.

6 GROUT MATERIAL: 1 Neat cement 2 Cement grout 3 Bentonite 4 Other
 Grout Intervals: From 0.5 ft. to 3 ft. From ft. to ft. From ft. to ft.
 What is the nearest source of possible contamination:
 1 Septic tank 4 Lateral lines 7 Pit privy 10 Livestock pens 14 Abandoned water well
 2 Sewer lines 5 Cess pool 8 Sewage lagoon 11 Fuel storage 15 Oil well/Gas well
 3 Watertight sewer lines 6 Seepage pit 9 Feedyard 12 Fertilizer storage 16 Other (specify below)
 13 Insecticide storage
 Direction from well? W How many feet? 250'

FROM	TO	LITHOLOGIC LOG	FROM	TO	PLUGGING INTERVALS
0	1	Fill	0	2'	Concrete Flushmant Per agreement w/ Mr Don Taylor w/ KDAE
1	8	Clay (CA)			
8	13	Clay (CL)			
13	15	Weathered LS			

7 CONTRACTOR'S OR LANDOWNER'S CERTIFICATION: This water well was (1) constructed, (2) reconstructed, or (3) plugged under my jurisdiction and was completed on (mo/day/year) 6/6/97 and this record is true to the best of my knowledge and belief. Kansas Water Well Contractor's License No. 531 This Water Well Record was completed on (mo/day/yr) 6/6/97 under the business name of Geotechnical Services, Inc by (signature) [Signature]

OFFICE USE ONLY
T
R
EM
SEC.
1/4
1/4
1/4