

CORRECTION(S) TO WATER WELL RECORD (WWC-5)
(to rectify lacking or incorrect information)

County: Douglas

Location listed as:

Location ~~changed to~~

Section-Township-Range: _____

36-12 S-19 E

Fraction (¼ ¼ ¼): _____

NE SE NE

Other changes: Initial statements: 609 East 9th Street, Lawrence.

Presta Oil Company, LLC

Changed to: 602 W. 9th St., Lawrence

Presto Oil Company, LLC.

Comments: _____

verification method: Local telephone directory, and online

directory of gasoline stations.

initials: DRK date: 9/30/2010


submitted by: Kansas Geological Survey, Data Resources Library, 1930 Constant Ave., Lawrence, KS 66047-3726
to: Kansas Dept of Health & Environment, Bureau of Water, 1000 SW Jackson, Suite 420, Topeka, KS 66612-1367.

1	LOCATION OF WATER WELL:	Fraction	Section Number	Township Number	Range Number
County:	Douglas	NE ¼ SE ¼ NE ¼	36	12S	19E EW

Distance and direction from nearest town or city street address of well if located within city?
 609 East 9th Street, Lawrence

2 WATER WELL OWNER: Presta Oil Company, LLC
 P.O. Box 609
 RR #, St. Address, Box #: Board of Agriculture, Division of Water Resources
 City, State, ZIP Code : Andover, KS 67002 Application Number:

3	MARK WELL'S LOCATION WITH AN 'X' IN SECTION BOX:	4	DEPTH OF WELL 14 ft. WELL'S STATIC WATER LEVEL 3.16 ft. WELL WAS USED AS: 1 Domestic 2 Irrigation 3 Feedlot 4 Industrial 5 Public Water Supply 6 Oil Field Water Supply 7 Domestic (Lawn & Garden) 8 Air Conditioning 9 Dewatering 10 Monitoring Well 11 Injection Well 12 Other
---	--	---	--

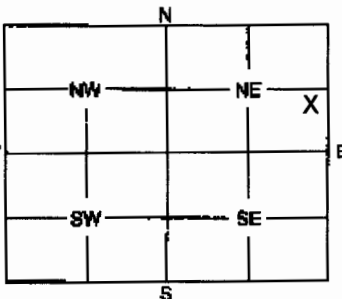

Was a chemical / bacteriological sample submitted to Department? Yes No X
 If yes, mo/day/yr sample was submitted
 Water Well Disinfected: Yes No X

5 TYPE OF BLANK CASING USED:
 1 Steel 3 RMP (SR) 5 Wrought 7 Fiberglass 9 Other (Specify below)
2 PVC 4 ABS 6 Asbestos-Cement 8 Concrete Tile
 Blank casing diameter 1 in. Was casing pulled? Yes X No
 Casing height above or below land surface 12 in. If yes, how much full length

6 GROUT PLUG MATERIAL: 1 Neat cement 2 Cement grout 3 Bentonite 4 Other
 Grout Plug Intervals: From 0 ft. to 14 ft. From ft. to ft. From ft. to ft.
 What is the nearest source of possible contamination:
 1 Septic tank 6 Seepage pit 11 Fuel storage 16 Other (specify below)
 2 Sewer lines 7 Pit privy 12 Fertilizer storage
 3 Waterright sewer lines 8 Sewage lagoon 13 Insecticide storage
 4 Lateral lines 9 Feedyard 14 Abandoned water well
 5 Cess pool 10 Livestock pens 15 Oil well/Gas well
 Direction from well? ENE How many feet? 450

FROM	TO	PLUGGING MATERIALS
0	14	Bentonite

7 CONTRACTOR'S OF LANDOWNER'S CERTIFICATION: This water well was plugged under my jurisdiction and was completed on (mo/day/year) 10/12/2006 and this record is true to the best of my knowledge and belief. Kansas Water Well Contractor's License No. 708A This Water Well Record was completed on (mo/day/year) 11/6/2006 under the business name of Aquaterra Environmental Solutions, Inc by (signature) *[Signature]*

INSTRUCTIONS: Use typewriter or ball point pen. Please press firmly and print clearly. Please fill in blanks, underline or circle the correct answers. Send top three copies to Kansas Department of Health and Environment, Bureau of Water, Geology Section, 1000 SW Jackson St., Ste. 420, Topeka, Kansas 66612-1367. Telephone: 785/296-5522. Send one to Water Well Owner and retain one for your records.