

CORRECTION(S) TO WATER WELL RECORD (WWC-5)
(to rectify lacking or incorrect information)

Location listed as:

Section-Township-Range: _____

Fraction ($\frac{1}{4}$ $\frac{1}{4}$ $\frac{1}{4}$): _____

County: Douglas

Location changed to:

36-12.5-19E

NE SE NE

Other changes: Initial statements: 609 East 9th Street, Lawrence.

Presta Oil Company, LLC

Changed to: 602 W. 9th St., Lawrence

Presto Oil Company, LLC.

Comments: _____

verification method: Local telephone directory, and online
directory of gasoline stations.


initials: DRJ date: 9/30/2010

submitted by: Kansas Geological Survey, Data Resources Library, 1930 Constant Ave., Lawrence, KS 66047-3726
to: Kansas Dept of Health & Environment, Bureau of Water, 1000 SW Jackson, Suite 420, Topeka, KS 66612-1367.

1	LOCATION OF WATER WELL:	Fraction	Section Number	Township Number	Range Number
County:	Douglas	NE ¼ SE ¼ NE ¼	36	12S	19E EW

Distance and direction from nearest town or city street address of well if located within city?
609 East 9th Street, Lawrence

2 WATER WELL OWNER: Presta Oil Company, LLC
 P.O. Box 609
 RR #, St. Address, Box #: Andover, KS 67002
 Board of Agriculture, Division of Water Resources
 Application Number:

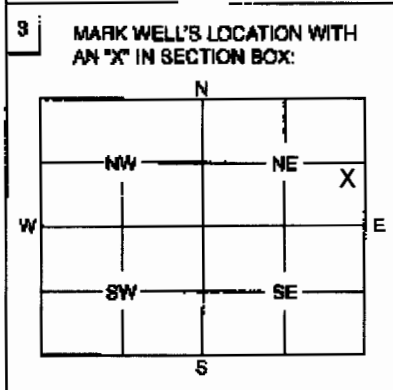

4 DEPTH OF WELL 20.2 ft.
 WELL'S STATIC WATER LEVEL 13.7 ft.
 WELL WAS USED AS:
 1 Domestic 5 Public Water Supply 9 Dewatering
 2 Irrigation 6 Oil Field Water Supply 10 Monitoring Well
 3 Feedlot 7 Domestic (Lawn & Garden) 11 Injection Well
 4 Industrial 8 Air Conditioning 12 Other
 Was a chemical / bacteriological sample submitted to Department? Yes No X
 If yes, mo/day/yr sample was submitted
 Water Well Disinfected: Yes No X

5 TYPE OF BLANK CASING USED:
 1 Steel 3 RMP (SR) 5 Wrought 7 Fiberglass 9 Other (Specify below)
 2 PVC 4 ABS 6 Asbestos-Cement 8 Concrete Tile
 Blank casing diameter 1 in. Was casing pulled? Yes X No If yes, how much full length
 Casing height above or below land surface 12 in.

6 GROUT PLUG MATERIAL: 1 Neat cement 2 Cement grout 3 Bentonite 4 Other
 Grout Plug Intervals: From 0 ft. to 20 ft. From ft. to ft. From to
 What is the nearest source of possible contamination:
 1 Septic tank 8 Sewage pit 11 Fuel storage 16 Other (specify below)
 2 Sewer lines 7 Pit privy 12 Fertilizer storage
 3 Water/tight sewer lines 8 Sewage lagoon 13 Insecticide storage
 4 Lateral lines 9 Feedyard 14 Abandoned water well
 5 Cess pool 10 Livestock pens 15 Oil well/Gas well
 Direction from well? NNE How many feet? 200

FROM	TO	PLUGGING MATERIALS
0	20	Bentonite

7 CONTRACTOR'S OF LANDOWNER'S CERTIFICATION: This water well was plugged under my jurisdiction and was completed on (mo/day/year) 10/12/2006 and this record is true to the best of my knowledge and belief. Kansas Water Well Contractor's License No. 708A This Water Well Record was completed on (mo/day/year) 11/6/2006 under the business name of Aquaterra Environmental Solutions, Inc.
 by (signature)

INSTRUCTIONS: Use typewriter or ball point pen. Please press firmly and print clearly. Please fill in blanks, underline or circle the correct answers. Send top three copies to Kansas Department of Health and Environment, Bureau of Water, Geology Section, 1000 SW Jackson St., Ste. 420, Topeka, Kansas 66612-1367. Telephone: 785/296-5522. Send one to Water Well Owner and retain one for your records.