


1	LOCATION OF WATER WELL:	Fraction <u>NE SW SW</u> ¼ ¼ ¼	Section Number <u>13</u>	Township Number <u>12 South</u>	Range Number <u>19</u> <u>EW</u>
County: <u>DEWELLS</u>					

Distance and direction from nearest town or city street address of well if located within city?  
± 680 N/NE OF N 1800 RD & IOWA STREET

2	WATER WELL OWNER: <u>WESTAR ENERGY</u> <u>LAWRENCE ENERGY CENTER</u>	Board of Agriculture, Division of Water Resources Application Number:
RR #, St. Address, Box #: <u>1250 N. 1800 RD</u>		
City, State, ZIP Code : <u>LAWRENCE KS 66044</u>		

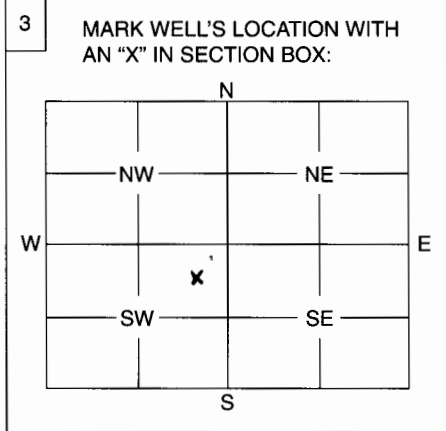

4	DEPTH OF WELL ..... <u>71</u> ..... ft.	
WELL'S STATIC WATER LEVEL ... <u>65</u> ..... ft. <u>BELOW SURFACE</u>		
WELL WAS USED AS:		
1 Domestic	5 Public Water Supply	9 Dewatering
2 Irrigation	6 Oil Field Water Supply	<u>10 Monitoring Well</u>
3 Feedlot	7 Domestic (Lawn & Garden)	11 Injection Well
4 Industrial	8 Air Conditioning	12 Other .....
Was a chemical / bacteriological sample submitted to Department? Yes ..... No <u>X</u> .....		
If yes, mo/day/yr sample was submitted .....		
Water Well Disinfected: Yes <u>X</u> No .....		

5	TYPE OF BLANK CASING USED:										
<table border="0"> <tr> <td>1 Steel</td> <td>3 RMP (SR)</td> <td>5 Wrought</td> <td>7 Fiberglass</td> <td>9 Other (Specify below)</td> </tr> <tr> <td><u>2 PVC</u></td> <td>4 ABS</td> <td>6 Asbestos-Cement</td> <td>8 Concrete Tile</td> <td></td> </tr> </table>		1 Steel	3 RMP (SR)	5 Wrought	7 Fiberglass	9 Other (Specify below)	<u>2 PVC</u>	4 ABS	6 Asbestos-Cement	8 Concrete Tile	
1 Steel	3 RMP (SR)	5 Wrought	7 Fiberglass	9 Other (Specify below)							
<u>2 PVC</u>	4 ABS	6 Asbestos-Cement	8 Concrete Tile								
Blank casing diameter <u>2</u> in. Was casing pulled? Yes ..... No <u>X</u> ..... If yes, how much .....											
Casing height above <u>below</u> land surface <u>36</u> in.											

6	GROUT PLUG MATERIAL: <u>1 Neat cement</u> 2 Cement grout 3 Bentonite 4 Other .....		
Grout Plug Intervals: From <u>65</u> ft. to <u>3</u> ft., From ..... ft. to ..... ft., From ..... to ..... ft.			
What is the nearest source of possible contamination:			
1 Septic tank	6 Seepage pit	11 Fuel storage	<u>16 Other (specify below)</u>
2 Sewer lines	7 Pit privy	12 Fertilizer storage	<u>LANDFILL</u>
3 Watertight sewer lines	8 Sewage lagoon	13 Insecticide storage	
4 Lateral lines	9 Feedyard	14 Abandoned water well	
5 Cess pool	10 Livestock pens	15 Oil well/Gas well	
Direction from well? <u>NW</u> How many feet? <u>600</u>			

FROM	TO	PLUGGING MATERIALS
<u>71</u>	<u>3</u>	<u>NEAT CEMENT</u>

7	CONTRACTOR'S OF LANDOWNER'S CERTIFICATION: This water well was plugged under my jurisdiction and was completed on (mo/day/year) <u>10/4/07</u> and this record is true to the best of my knowledge and belief. Kansas Water Well Contractor's License No. <u>10/5/07</u> under the business name of <u>SCHMIDTLEIN EXCAVATING, INC.</u> This Water Well Record was completed on (mo/day/year) <u>10/5/07</u> by (signature) <u>[Signature]</u>
---	--

INSTRUCTIONS: Use typewriter or ball point pen. Please press firmly and print clearly. Please fill in blanks, underline or circle the correct answers. Send top three copies to Kansas Department of Health and Environment, Bureau of Water, Geology Section, 1000 SW Jackson St., Ste. 420, Topeka, Kansas 66612-1367. Telephone: 785/296-5522. Send one to Water Well Owner and retain one for your records.