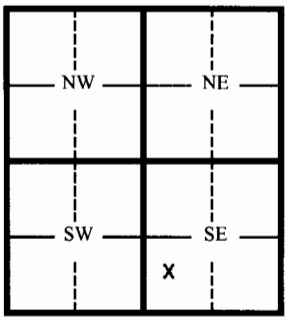


1 LOCATION OF WATER WELL:	Fraction	Section Number	Township Number	Range Number
County: Douglas	NW ¼ SW ¼ SE ¼	25	12	19-East

Distance and direction from nearest town or city street address of well if located within city?
1306 W. 6th Street, Lawrence, Kansas

2 WATER WELL OWNER: **Jayhawk Oil Company**
 RR#, St. Address, Box # **P.O. Box 4058**
 City, State, ZIP Code : **Lawrence, Kansas 66046**
 Board of Agriculture, Division of Water Resources
 Application Number:

3 MARK WELL'S LOCATON WITH AN "X" IN SECTION BOX:	4 DEPTH OF WELL 20.0 ft.												
	WELL'S STATIC WATER LEVEL 14.65 ft.												
	WELL WAS USED AS:												
	<table style="width:100%;"> <tr> <td>1 Domestic</td> <td>5 Public Water Supply</td> <td>9 Dewatering</td> </tr> <tr> <td>2 Irrigation</td> <td>6 Oil Field Water Supply</td> <td>10 Monitoring Well</td> </tr> <tr> <td>3 Feedlot</td> <td>7 Lawn and Garden (domestic)</td> <td>11 Injection Well</td> </tr> <tr> <td>4 Industrial</td> <td>8 Air Conditioning</td> <td>12 Other</td> </tr>
Was a chemical/bacteriological sample submitted to Department? Yes ___ No X													
If yes, mo/day/yr sample was submitted _____													
Water Well Disinfected: Yes ___ No X													

5 TYPE OF BLANK CASING USED:

1 Steel	3 RMP (SR)	5 Wrought	7 Fiberglass	9 Other (specify below)
2 PVC	4 ABC	6 Asbestos-Cement	8 Concrete Tile	

Blank casing diameter **2.375** in. Was casing pulled? Yes ___ No **X** If yes, how much? **N/A**

Casing height above or below land surface **Unknown** in. **Casing plugged; casing removed to depth of 3' BTOC.**

6 GROUT PLUG MATERIAL: 1 Neat cement 2 Cement grout **3 Bentonite** **4 Other** **Soils**

Grout Plug Intervals From **20.0** ft. to **3.0** ft. From **3.0** ft. to **0.0** ft. From ___ ft. to ___ ft.

What is the nearest source of possible contamination:

1 Septic tank	6 Seepage pit	11 Fuel storage (former)	16 Other (specify below)
2 Sewer lines	7 Pit privy	12 Fertilizer storage	
3 Watertight sewer lines	8 Sewage lagoon	13 Insecticide storage	
4 Lateral lines	9 Feedyard	14 Abandoned water well	
5 Cess Pool	10 Livestock pens	15 Oil well/ Gas well	

Direction from well? **Southwest** How many feet? **185**

FROM	TO	CODE	PLUGGING MATERIALS
0.0	3.0		Compacted soils
3.0	20.0		Bentonite chips

7 CONTRACTOR'S OR LANDOWNER'S CERTIFICATION: This water well was plugged under my jurisdiction and was completed on (mo/day/yr) **03/26/08** and this record is true to the best of my knowledge and belief. Kansas Water Well Contractor's License No. **692** This Water Well Record was completed on (mo/day/yr) **03/27/08** under the business name of **Quad State Services, Inc.** by (signature) *[Signature]*

INSTRUCTIONS: Please fill in blanks and circle the correct answers. Send three copies to Kansas Department of Health and Environment, Bureau of Water, 1000 S W Jackson St., Ste. 420, Topeka, Kansas 66620-0001. Telephone: 785-296-3565. Send one to Water Well Owner and retain one for your records.