


1 LOCATION OF WATER WELL: County: Douglas	Fraction NW ¼ SW ¼ SE ¼	Section Number 25	Township Number T 12 S	Range Number R 19 EW
---	--------------------------------	--------------------------	-------------------------------	---

Distance and direction from nearest town or city street address of well if located within city?

1306 W. 6th Street, Lawrence, Kansas

2 WATER WELL OWNER: Jayhawk Oil Company RR#, St. Address, Box # : P.O. Box 4058 City, State, ZIP Code : Lawrence, Kansas 66046	Board of Agriculture, Division of Water Resources Application Number:
---	--

3 LOCATE WELL'S LOCATION WITH AN "X" IN SECTION BOX:

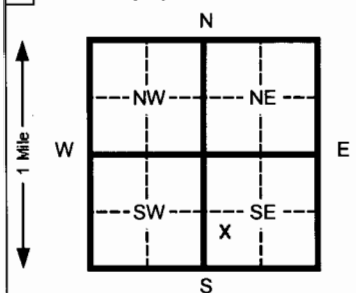

4 DEPTH OF COMPLETED WELL 30.0 ft. ELEVATION: _____	Depth(s) Groundwater Encountered 1 17.0 ft. 2 _____ ft. 3 _____ ft.
WELL'S STATIC WATER LEVEL 8.51 ft. below land surface measured on mo/day/yr 03/27/08	Pump test data: Well water was _____ ft. after _____ hours pumping _____ gpm
Est. Yield NA gpm: Well water was _____ ft. after _____ hours pumping _____ gpm	Bore Hole Diameter 8.5 in. to 30.0 ft. and _____ in. to _____ ft.
WELL WATER TO BE USED AS: 5 Public water supply 8 Air conditioning 11 Injection well 1 Domestic 3 Feed lot 6 Oil field water supply 9 Dewatering 12 Other (Specify below)	2 Irrigation 4 Industrial 7 Lawn and garden (domestic) 10 Monitoring well
Was a chemical/bacteriological sample submitted to Department? Yes _____ No <input checked="" type="checkbox"/> If yes, mo/day/yr sample was submitted _____	Water Well Disinfected? Yes _____ No <input checked="" type="checkbox"/>

5 TYPE OF BLANK CASING USED: 1 Steel 2 PVC 3 RMP (SR) 4 ABS	5 Wrought Iron 6 Asbestos-Cement 7 Fiberglass	8 Concrete tile 9 Other (specify below) CASING JOINTS: Glued _____ Clamped _____ Welded _____ Threaded <input checked="" type="checkbox"/>
Blank casing diameter 2.375 in. to 8.0 ft., Dia _____ in. to _____ ft., Dia _____ in. to _____ ft.	Casing height above land surface Flush Mount in., weight _____ lbs./ft. Wall thickness or gauge No. Schedule 40	TYPE OF SCREEN OR PERFORATION MATERIAL: 1 Steel 3 Stainless steel 5 Fiberglass 7 PVC 10 Asbestos-cement 2 Brass 4 Galvanized steel 6 Concrete tile 8 RMP (SR) 11 Other (specify) _____ 9 ABS 12 None used (open hole)
SCREEN OR PERFORATION OPENINGS ARE: 1 Continuous slot 3 Mill slot 5 Gauzed wrapped 8 Saw cut 11 None (open hole) 2 Louvered shutter 4 Key punched 6 Wire wrapped 9 Drilled holes 7 Torch cut 10 Other (specify) _____	SCREEN-PERFORATED INTERVALS: From 30.0 ft. to 8.0 ft. From _____ ft. to _____ ft. From _____ ft. to _____ ft. From _____ ft. to _____ ft.	GRAVEL PACK INTERVALS: From 30.0 ft. to 7.0 ft. From _____ ft. to _____ ft. From _____ ft. to _____ ft. From _____ ft. to _____ ft.

6 GROUT MATERIAL: 1 Neat cement 2 Cement grout 3 Bentonite 4 Other	Grout Intervals From 0.0 ft. to 1.0 ft. From 1.0 ft. to 7.0 ft. From _____ ft. to _____ ft.	What is the nearest source of possible contamination: 1 Septic tank 4 Lateral lines 7 Pit privy 10 Livestock pens 14 Abandoned water well 2 Sewer lines 5 Cess pool 8 Sewage lagoon 11 Fuel storage (former) 15 Oil well/ Gas well 3 Watertight sewer lines 6 Seepage pit 9 Feedyard 12 Fertilizer storage 16 Other (specify below) _____ 13 Insecticide storage
Direction from well? Southeast-south How many feet? 70		

FROM	TO	CODE	LITHOLOGIC LOG
0.0	1.0		Concrete
1.0	6.0		Fill material; dark gray, brown, olive, silty clay, aggregate, friable, moist
6.0	10.0		Gray silty clay, very firm, moist
10.0	14.0		Brown silty clay, slightly gravelly, slightly mottled black, firm, moist
14.0	17.0		Brown-yellow brown very silty clay, firm, slightly moist
17.0	22.0		Brown-yellow brown very silty clay, sandy, very moist-saturated
22.0	23.0		Brown-yellow brown very silty clay, slightly sandy, firm, moist
23.0	27.0		Brown weathered shale, very firm, moist
27.0	28.5		Brown very silty clay, sandy, saturated
28.5	30.0		Brown-dark brown silty clay, firm, slightly moist
Flush-mount well completion waiver existent for site.			

7 CONTRACTOR'S OR LANDOWNER'S CERTIFICATION: This water well was 1 constructed, (2) reconstructed, or (3) plugged under my jurisdiction and was completed on (mo/day/yr) 03/26/08 and this record is true to the best of my knowledge and belief. Kansas	This Water Well Record was completed on (mo/day/yr) 03/27/08
Water Well Contractor's License No. 692	by (signature)
under the business name of Quad State Services, Inc.	

INSTRUCTIONS: Please fill in blanks and circle the correct answers. Send three copies to Kansas Department of Health and Environment, Bureau of Water, 1000 S W Jackson St., Ste. 420, Topeka, Kansas 66612-1367. Telephone: 913-296-5545. Send one to WATER WELL OWNER and retain one for your records.