


1 LOCATION OF WATER WELL: County: Douglas	Fraction SW ¼ NE ¼ SW ¼	Section Number 13	Township Number 12 South	Range Number 19 E
--	-----------------------------------	-----------------------------	------------------------------------	-----------------------------

Distance and direction from nearest town or city street address of well if located within city?
1250 N 1800 Rd, Lawrence, KS

2 WATER WELL OWNER: Westar Energy
 RR#, St. Address, Box #: **1250 N 1800 Rd**
 City, State, ZIP Code: **Lawrence, KS 66044**

Global Positioning System (decimal degrees, min. of 4 digits)
 Latitude: 39.00434
 Longitude: -95.25643
 Elevation: 863.4
 Datum: NAP 8.3
 Data Collection Method: Garmin GP5

3 MARK WELL'S LOCATION WITH AN "X" IN SECTION BOX:

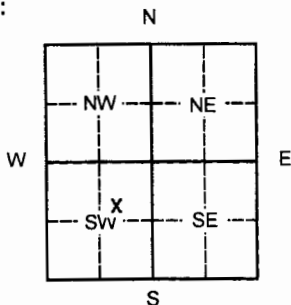

4 DEPTH OF WELL 24.20 ft.
 WELL'S STATIC WATER LEVEL 21.95 ft.
 WELL WAS USED AS:
 1 Domestic 5 Public Water Supply 9 Dewatering
 2 Irrigation 6 Oil Field Water Supply 10 Monitoring
 3 Feedlot 7 Domestic (Lawn & Garden) 11 Injection Well
 4 Industrial 8 Air Conditioning 12 Other Hand Dug
 Was a chemical/bacteriological sample submitted to Department? Yes ___ No ___

5 TYPE OF BLANK CASING USED:
 1 Steel 3 RMP (SR) 5 Wrought 7 Fiberglass 9 Other (Specify below)
 2 PVC 4 ABS 6 Asbestos-Cement 8 Concrete Tile

Blank casing diameter 36 in. Was casing pulled? Yes ___ No X If yes, how much Removed to 6.2' below grade
 Casing height above or below land surface 74.4 in.

6 GROUT PLUG MATERIAL: 1 Neat cement 2 Cement grout 3 Bentonite 4 Other Soil

Grout Plug Intervals: From 24.20 ft. to 6.70 ft., From 6.70 ft. to 4.70 ft., From 4.70 to 0 ft.

What is the nearest source of possible contamination:
 1 Septic tank 6 Seepage pit 11 Fuel Storage 16 Other (specify below)
 2 Sewer lines 7 Pit privy 12 Fertilizer storage Ash Landfill #847
 3 Watertight sewer lines 8 Sewage lagoon 13 Insecticide storage
 4 Lateral lines 9 Feedyard 14 Abandoned water well Direction from well? West
 5 Cess pool 10 Livestock pens 15 Oil well/Gas well How many feet? Less than 50 feet

FROM	TO	PLUGGING MATERIALS	FROM	TO	PLUGGING MATERIALS
24.20	6.70	Neat Cement			
6.70	4.70	Hydrated Bentonite Chips			
4.70	0	Compacted Clay Soil			

7 CONTRACTOR'S OR LANDOWNER'S CERTIFICATION: This water well was plugged under my jurisdiction and was completed on (mo/day/year) 12/15/2010 and this record is true to the best of my knowledge and belief. Kansas Water Well Contractor's License No. 531. This Water Well Record was completed on (mo/day/year) 12/25/2010 under the business name of Geotechnical Services, Inc. by (signature) [Signature]

INSTRUCTIONS: Please fill in blanks or circle the correct answers. Send top three copies to Kansas Department of Health and Environment, Bureau of Water, Geology Section, 1000 SW Jackson St., Ste. 420, Topeka, Kansas 66612-1367. Telephone: 785/296-5522. Send one to Water Well Owner and retain one for your records. Visit us at <http://www.kdheks.gov/waterwell>.