

#1

WATER WELL PLUGGING RECORD Form WWC-5P KSA 82a-1212 ID NO. [ ]

1 LOCATION OF WATER WELL: County: DOUGLAS Fraction SW 1/4 SW 1/4 NE 1/4 Section Number 14 Township Number 12 Range Number 19 E/W


Distance and direction from nearest town or city street address of well if located within city?

1250N 1800 Rd LAWRENCE, KS 66049

2 WATER WELL OWNER: WESTAR RR#, St. Address, Box #: 1250N 1800 Rd City, State ZIP Code: LAWRENCE, KS 66049

Global Positioning Systems (decimal degrees, min. of 4 digits Latitude: Longitude: Elevation: Datum: Data Collection Method:

3 MARK WELL'S LOCATION WITH AN "X" IN SECTION BOX:

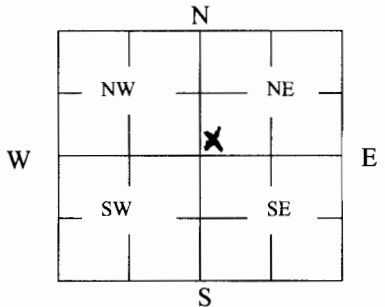

4 DEPTH OF WELL 39' ft. WELL'S STATIC WATER LEVEL 18' ft.

WELL WAS USED AS:

- 1 Domestic 2 Irrigation 3 Feedlot 4 Industrial 5 Public Water Supply 6 Oil Field Water Supply 7 Domestic (Lawn & Garden) 8 Air Conditioning 9 Dewatering 10 Monitoring 11 Injection Well 12 Other

Was a chemical/bacteriological sample submitted to Department? Yes No X

5 TYPE OF BLANK CASING USED: 1 Steel 2 PVC 3 RMP (SR) 4 ABS 5 Wrought 6 Asbestos-Cement 7 Fiberglass 8 Concrete Tile 9 Other (Specify below)

Blank casing diameter 24" in. Was casing pulled? Yes No X If yes, how much Casing height above or below land surface 5 FT X

6 GROUT PLUG MATERIAL: 1 Neat cement 2 Cement grout 3 Bentonite 4 Other

Grout Plug Intervals: From 38 ft. to 5' ft., From ft. to ft., From to ft.

What is the nearest source of possible contamination:

- 1 Septic tank 2 Sewer lines 3 Watertight sewer lines 4 Lateral lines 5 Cess pool 6 Seepage pit 7 Pit privy 8 Sewage lagoon 9 Feedyard 10 Livestock pens 11 Fuel Storage 12 Fertilizer storage 13 Insecticide storage 14 Abandoned water well 15 Oil well/Gas well 16 Other (specify below) RAILROAD TRACKS Direction from well? NORTH How many feet? 10'

Table with columns: FROM, TO, PLUGGING MATERIALS. Row 1: 38-5, Neat Cement Grout. Row 2: 5-0, TOP SOIL.

7 CONTRACTOR'S OR LANDOWNER'S CERTIFICATION: This water well was plugged under my jurisdiction and was completed on (mo/day/year) 9-29-15 and this record is true to the best of my knowledge and belief. Kansas Water Well Contractor's License No. 1536 This Water Well Record was completed on (mo/day/year) 10-6-15 under the business name of Patchen Pump & Well Drilling, Inc by (signature) Tom E. Patchen

INSTRUCTIONS: Use typewriter or ballpoint pen. Please press firmly and print clearly. Please fill in blanks, underline or circle the correct answers. Send top three copies to Kansas Department of Health and Environment, Bureau of Water, Geology Section, 1000 SW Jackson St., Ste. 420, Topeka, Kansas 66612-1367. Telephone: 785/296-5522. Send one to Water Well Owner and retain one for your records. Visit us at http://www.kdheks.gov/geo/waterwells.