

#3


WATER WELL PLUGGING RECORD Form WWC-5P KSA 82a-1212 ID NO.

1 LOCATION OF WATER WELL: County: DOUGLAS Fraction: NW 1/4 SE 1/4 NW 1/4 Section Number: 14 Township Number: 12 Range Number: 19 EW

Distance and direction from nearest town or city street address of well if located within city?

1250 N 1800 RD LAWRENCE, KS 66049

2 WATER WELL OWNER: Westar RR#, St. Address, Box #: 1250 N 1800 RD City, State ZIP Code: LAWRENCE, KS 66049 Global Positioning Systems (decimal degrees, min. of 4 digits) Latitude: Longitude: Elevation: Datum: Data Collection Method:

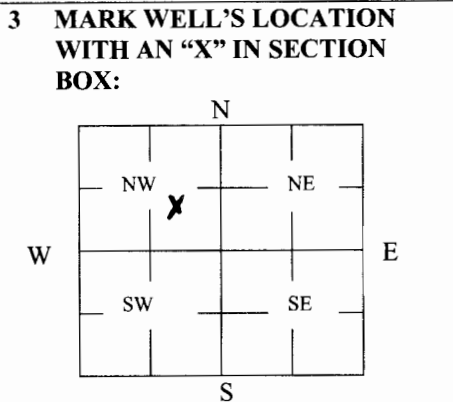

4 DEPTH OF WELL: 43' ft. WELL'S STATIC WATER LEVEL: 13' ft. WELL WAS USED AS: 1 Domestic, 2 Irrigation, 3 Feedlot, 4 Industrial, 5 Public Water Supply, 6 Oil Field Water Supply, 7 Domestic (Lawn & Garden), 8 Air Conditioning, 9 Dewatering, 10 Monitoring, 11 Injection Well, 12 Other. Was a chemical/bacteriological sample submitted to Department? Yes No X

5 TYPE OF BLANK CASING USED: 1 Steel, 2 PVC, 3 RMP (SR), 4 ABS, 5 Wrought, 6 Asbestos-Cement, 7 Fiberglass, 8 Concrete Tile, 9 Other (Specify below). Blank casing diameter: 24" in. Was casing pulled? Yes No X. Casing height above or below land surface: 5 ft.

6 GROUT PLUG MATERIAL: 1 Neat cement, 2 Cement grout, 3 Bentonite, 4 Other. Grout Plug Intervals: From 43 ft. to ft., From ft. to ft., From ft. to ft. What is the nearest source of possible contamination: 1 Septic tank, 2 Sewer lines, 3 Watertight sewer lines, 4 Lateral lines, 5 Cess pool, 6 Seepage pit, 7 Pit privy, 8 Sewage lagoon, 9 Feedyard, 10 Livestock pens, 11 Fuel Storage, 12 Fertilizer storage, 13 Insecticide storage, 14 Abandoned water well, 15 Oil well/Gas well, 16 Other (specify below): RAILROAD TRACKS. Direction from well? North. How many feet? 50'

Table with 6 columns: FROM, TO, PLUGGING MATERIALS, FROM, TO, PLUGGING MATERIALS. Row 1: 43-5 - Neat Cement Grout. Row 2: 5-0 - TOP Soil.

7 CONTRACTOR'S OR LANDOWNER'S CERTIFICATION: This water well was plugged under my jurisdiction and was completed on (mo/day/year) 9-29-15 and this record is true to the best of my knowledge and belief. Kansas Water Well Contractor's License No. 536. This Water Well Record was completed on (mo/day/year) 10-6-15 under the business name of Patcher Pump & Well Drilling, Inc. by (signature) Tom E. Patcher

INSTRUCTIONS: Use typewriter or ballpoint pen. Please press firmly and print clearly. Please fill in blanks, underline or circle the correct answers. Send top three copies to Kansas Department of Health and Environment, Bureau of Water, Geology Section, 1000 SW Jackson St., Ste. 420, Topeka, Kansas 66612-1367. Telephone: 785/296-5522. Send one to Water Well Owner and retain one for your records. Visit us at http://www.kdheks.gov/geo/waterwells.