


WATER WELL PLUGGING RECORD Form WWC-5P KSA 82a-1212 ID NO. []

1 LOCATION OF WATER WELL: Fraction SE 1/4 SE 1/4 NW 1/4 Section Number 14 Township Number 12 Range Number 19 E/W
 County: Douglas
 Distance and direction from nearest town or city street address of well if located within city?
1750 N 1800 Rd Lawrence, KS 66049

2 WATER WELL OWNER: WESTAR Global Positioning Systems (decimal degrees, min. of 4 digits)
 RR#, St. Address, Box #: 1750 N 1800 Rd Latitude: _____
 City, State ZIP Code: Lawrence, KS 66049 Longitude: _____
 Elevation: _____
 Datum: _____
 Data Collection Method: _____

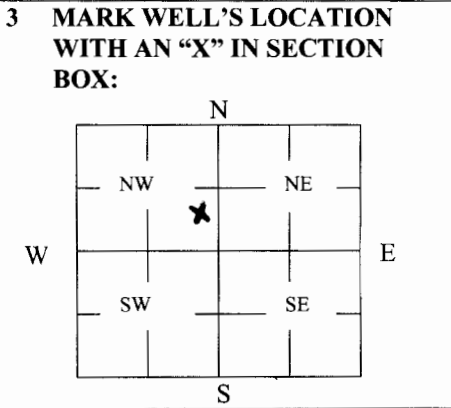

4 DEPTH OF WELL 48' ft.
 WELL'S STATIC WATER LEVEL 15' ft.
 WELL WAS USED AS:
 1 Domestic 5 Public Water Supply 9 Dewatering
 2 Irrigation 6 Oil Field Water Supply 10 Monitoring
 3 Feedlot 7 Domestic (Lawn & Garden) 11 Injection Well
 4 Industrial 8 Air Conditioning 12 Other _____
 Was a chemical/bacteriological sample submitted to Department? Yes _____ No X

5 TYPE OF BLANK CASING USED:
 Steel 3 RMP (SR) 5 Wrought 7 Fiberglass 9 Other (Specify below)
 2 PVC 4 ABS 6 Asbestos-Cement 8 Concrete Tile _____
 Blank casing diameter 24" in. Was casing pulled? Yes _____ No X If yes, how much _____
 Casing height above or below land surface 5 FT ft.

6 GROUT PLUG MATERIAL: Neat cement 2 Cement grout 3 Bentonite 4 Other _____
 Grout Plug Intervals: From 48 ft. to 5 ft., From _____ ft. to _____ ft., From _____ to _____ ft.

What is the nearest source of possible contamination:
 1 Septic tank 6 Seepage pit 11 Fuel Storage 16 Other (specify below) Railroad tracks
 2 Sewer lines 7 Pit privy 12 Fertilizer storage
 3 Watertight sewer lines 8 Sewage lagoon 13 Insecticide storage
 4 Lateral lines 9 Feedyard 14 Abandoned water well Direction from well? North
 5 Cess pool 10 Livestock pens 15 Oil well/Gas well How many feet? 25'

FROM	TO	PLUGGING MATERIALS	FROM	TO	PLUGGING MATERIALS
<u>48</u>	<u>5</u>	<u>Neat Cement Grout</u>			
<u>5</u>	<u>0</u>	<u>Top Soil</u>			

7 CONTRACTOR'S OR LANDOWNER'S CERTIFICATION: This water well was plugged under my jurisdiction and was completed on (mo/day/year) 9-29-15 and this record is true to the best of my knowledge and belief. Kansas Water Well Contractor's License No. 536. This Water Well Record was completed on (mo/day/year) 10-6-15 under the business name of Patchen Pumps & Well Drilling, Inc by (signature) Tom E. Patchen

INSTRUCTIONS: Use typewriter or ballpoint pen. Please press firmly and print clearly. Please fill in blanks, underline or circle the correct answers. Send top three copies to Kansas Department of Health and Environment, Bureau of Water, Geology Section, 1000 SW Jackson St., Ste. 420, Topeka, Kansas 66612-1367. Telephone: 785/296-5522. Send one to Water Well Owner and retain one for your records. Visit us at <http://www.kdheks.gov/geo/waterwells>.