

MW23

1 LOCATION OF WATER WELL: County: Douglas	Fraction	Section Number	Township Number	Range Number
	NW¼ SW¼ SW¼ NW¼	35	T 12 S	19 <input checked="" type="checkbox"/> E <input type="checkbox"/> W

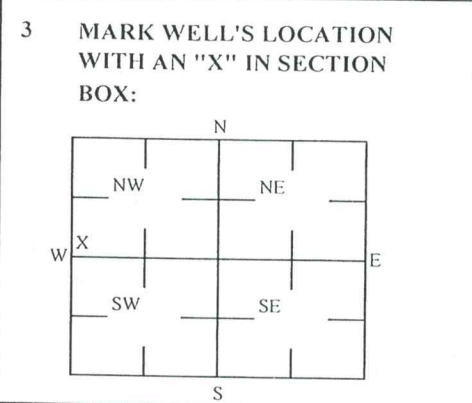
Street/Rural Address of Well Location; if unknown, distance & direction from nearest town or intersection: If at owner's address, check here
900 Iowa St, Lawrence, KS 6044

Global Positioning Systems (GPS) information:
Latitude: 38.96647 (in decimal degrees)
Longitude: 95.25978 (in decimal degrees)
Elevation: NA

Horizontal Datum WGS84, NAD83, NAD27
Collection Method:

2 WATER WELL OWNER: Zarco Inc.
RR#, St. Address, Box #: 718 E 1300 Rd
City, State ZIP Code: Lawrence, KS 66046

GPS unit (Make/model): _____
 Digital Map/Photo, Topographic Map Land Survey
Est. Accuracy: <3 m, 3-5 m, 5-15 m, >15 m



4 DEPTH OF WELL 10.7 ft. MW23
WELL'S STATIC WATER LEVEL _____ ft
WELL WAS USED AS:
 Domestic Public Water Supply Dewatering
 Irrigation Oil Field Water Supply Monitoring
 Feedlot Domestic (Lawn & Garden) Injection Well
 Industrial Air Conditioning Other _____
Was a chemical/bacteriological sample submitted to Department? Yes No

5 TYPE OF BLANK CASING USED:
 Steel RMP (SR) Wrought Fiberglass Other (Specific below)
 PVC ABS Asbestos-Cement Concrete Tile
Blank casing diameter 2 in. Was casing pulled? Yes No If yes, how much 3'
Casing height above or below land surface NA in.

6 GROUT PLUG MATERIAL: Neat cement Cement grout Bentonite Other Asphalt: 0-0.5'; Soil: 0.5-1'
Grout Plug Intervals: From 1 ft to 10.7 ft, From _____ ft to _____ ft, From _____ ft to _____ ft.
What is the nearest source of possible contamination:
 Septic tank Seepage pit Fuel storage Other (specify below)
 Sewer lines Pit privy Fertilizer storage
 Watertight sewer lines Sewage lagoon Insecticide storage
 Lateral lines Feed yard Abandoned water well Direction from well? _____
 Cess pool Livestock pens Oil well/Gas well How many feet? _____

FROM	TO	PLUGGING MATERIALS	FROM	TO	PLUGGING MATERIALS
0	0.5	Asphalt			
0.5	1	Soil			
1	10.7	Bentonite			
KDHE ID: Zarco 66 #3/First Fuel Bank #2; U4-023-13174					

7 CONTRACTOR'S OR LANDOWNER'S CERTIFICATION: This water well was plugged under my jurisdiction and was completed on (mo/day/year) 4/19/2022 and this record is true to the best of my knowledge and belief. Kansas Water Contractor's License No. 757. This Water Well Record was completed on (mo/day/year) 7/1/2019 under the business name of Larsen & Associates, Inc. By (signature) _____

Send one white copy to Kansas Department of Health & Environment, Geology Section, 1080 SW Jackson Street, Ste. 420, Topeka, KS 66612-1367. Send one copy to WATER WELL OWNER and retain one for your records
Visit us at <http://www.kdheks.gov/waterwell/index.html> Telephone 785-296-5524.

NOTE: Figures exhibited within this report are only to be used within the context of this report. Placement of property lines, wells, structures, and roads is based on the available information from county appraiser maps, surveys, site visits, and/or previous vendor reports and should be considered approximate.

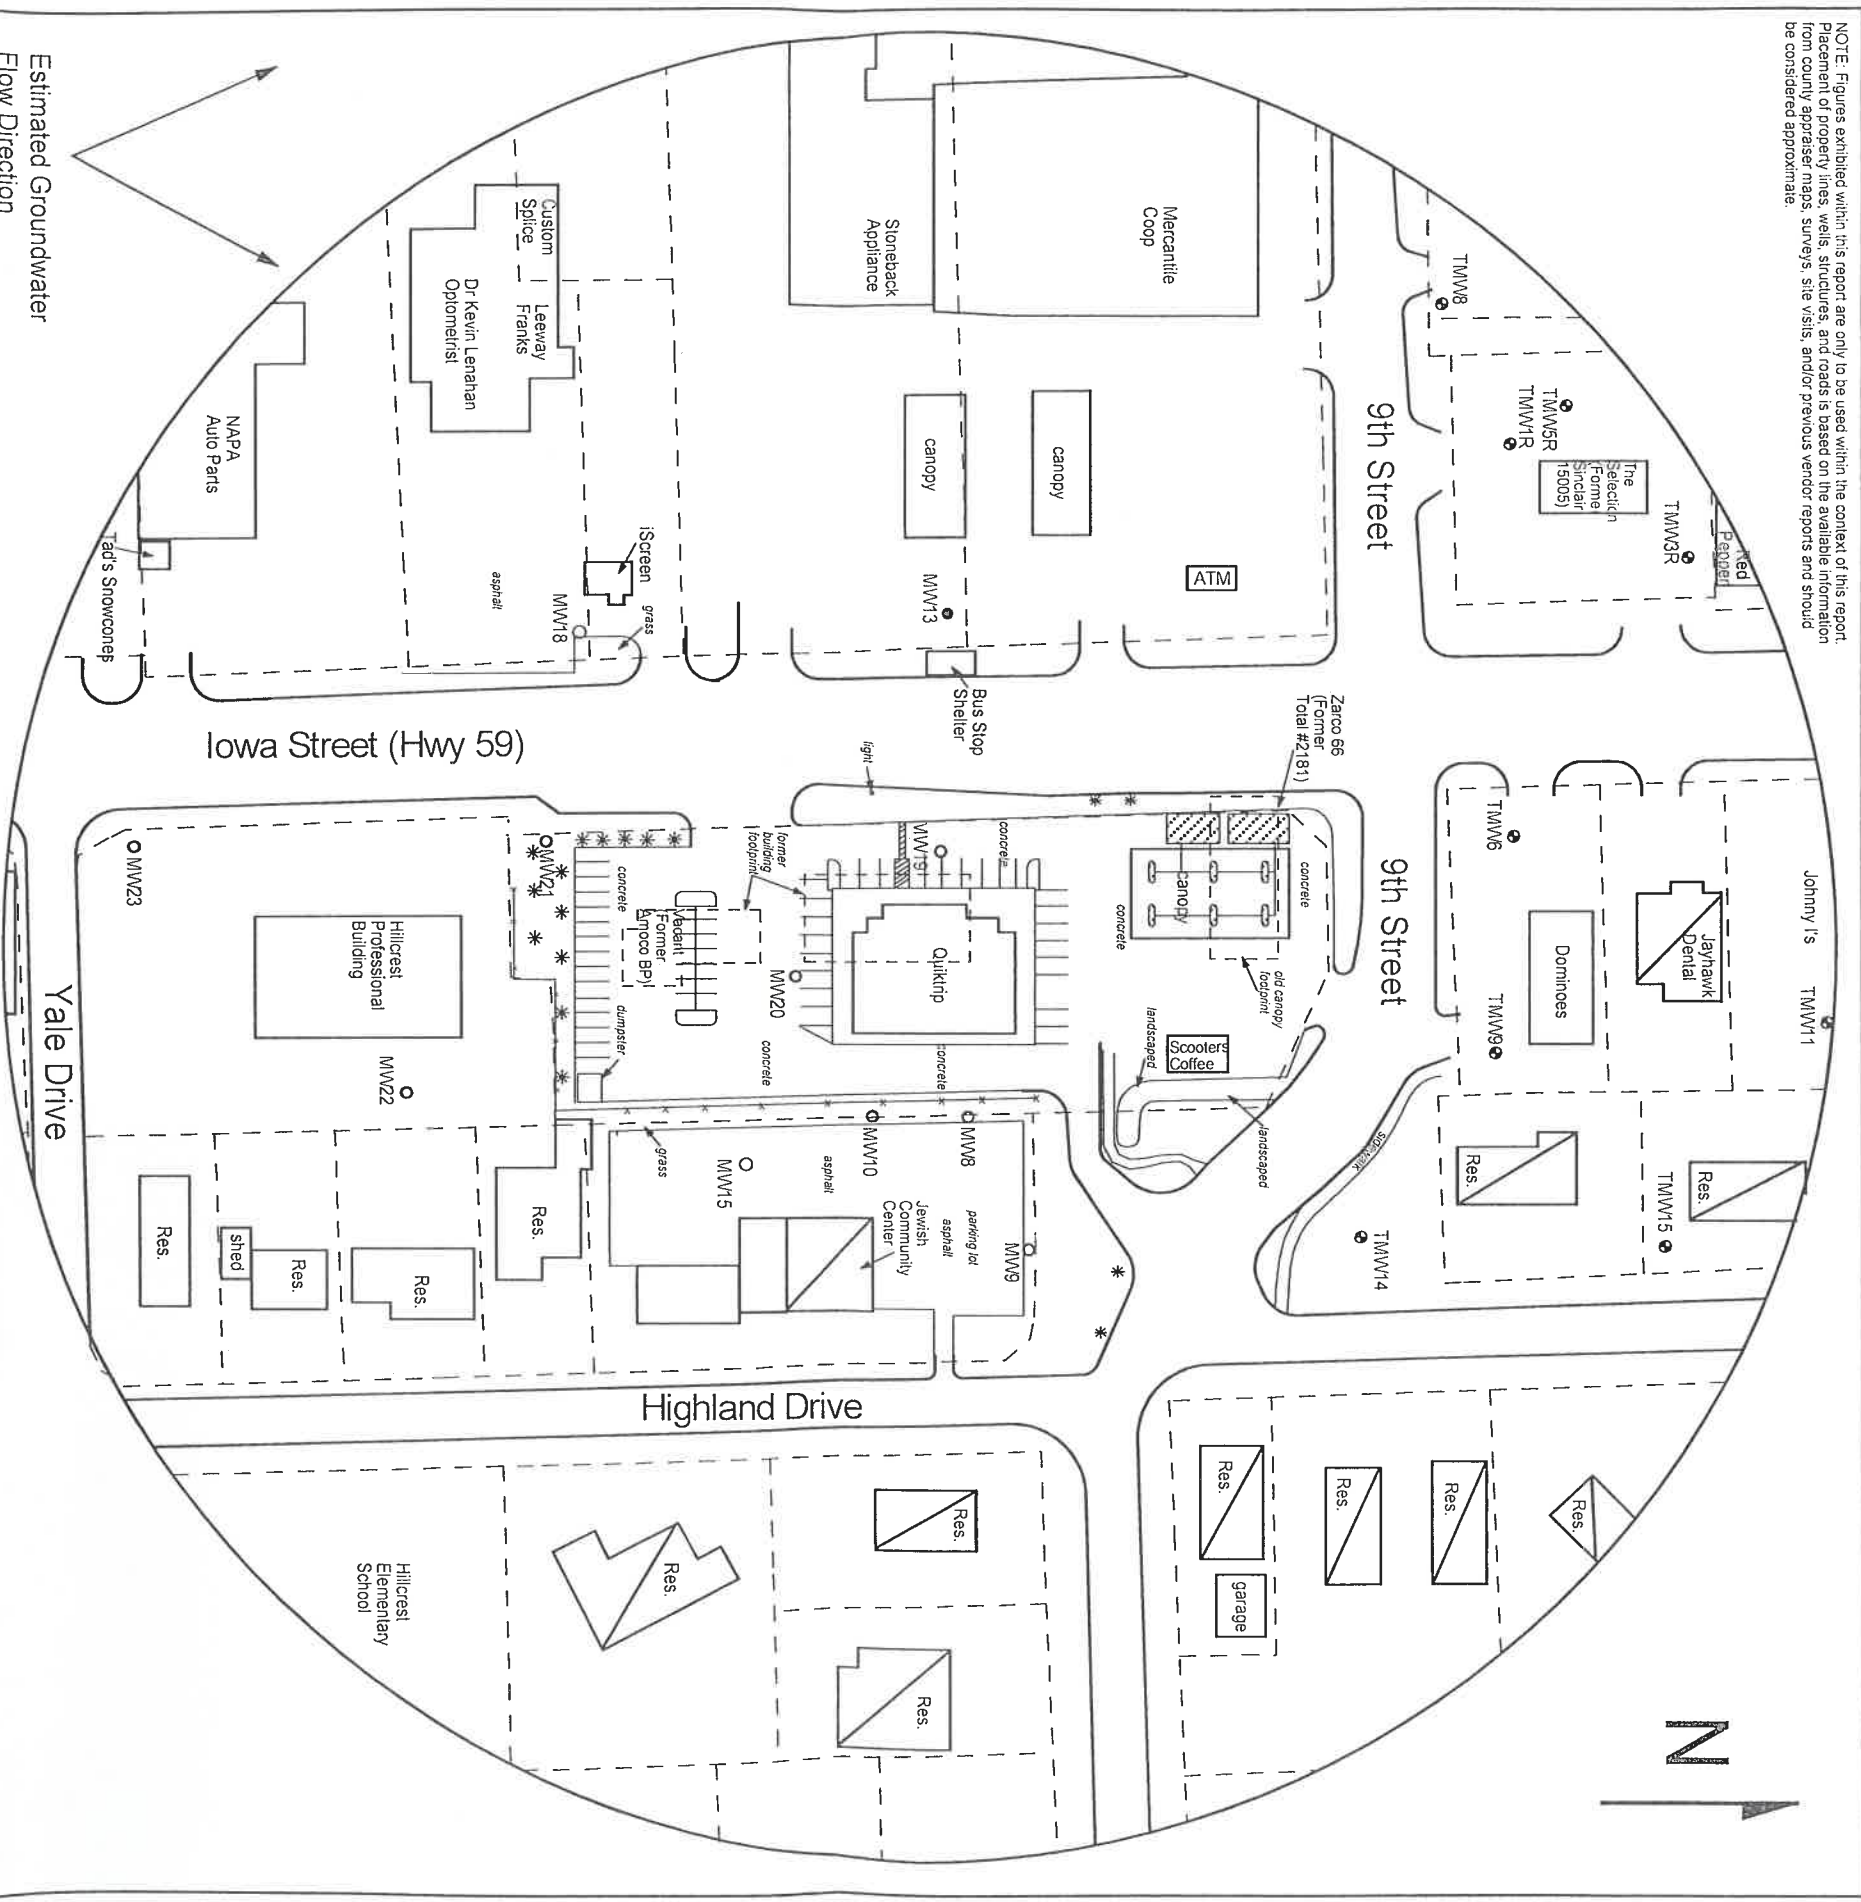




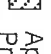
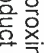
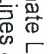
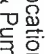
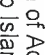
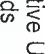
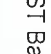
FIGURE 1 - 500 FT RADIUS AREA BASE MAP


larsen
 & ASSOCIATES, INC.

1311 E 25th St., Suite B 785-841-8707 office
 Lawrence, KS 66046 785-865-4282 fax

PROJECT:
 Zarco 66 #3/First Fuel Bank #2
 900 Iowa
 Lawrence, KS
 KDHE ID: U4-023-13174
 Date: 4/19/22

LEGEND

-  Approximate Location of Active UST Basin,
-  Product Lines & Pump Islands
-  Approximate Location of Former UST Basin, Product Lines & Pump Islands
-  Building with Basement
-  Approximate Location of Property Line
-  Existing Monitoring Well
-  Plugged Monitoring Well
-  Monitoring Well at Nearby LUST Sites Total Retail #2181 (U4-023-01573) & Sinclair #15005 (U4-023-10255)

