


1 LOCATION OF WATER WELL: Fraction SE 1/4 NE 1/4 NE 1/4 Section Number 32 Township Number T 12 S Range Number R 2 E  
 County: Dickinson

Distance and direction from nearest town or city street address of well if located within city?  
2 miles East of Talmage, Ks on Hwy 18 & 4 3/8 miles South

2 WATER WELL OWNER: Connie Hunter  
 RR#, St. Address, Box # : 2563 Gulf Rd Board of Agriculture, Division of Water Resources  
 City, State, ZIP Code : Abilene, Kansas 67410 Application Number:

3 LOCATE WELL'S LOCATION WITH AN "X" IN SECTION BOX:

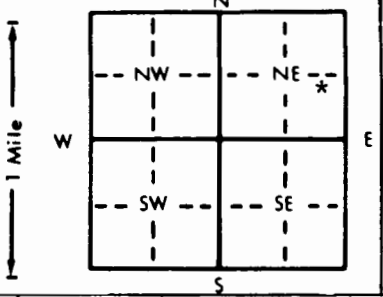

4 DEPTH OF COMPLETED WELL: 70 ft. ELEVATION:  
 Depth(s) Groundwater Encountered 1. 58 ft. 2. ft. 3. ft.  
 WELL'S STATIC WATER LEVEL 35 ft. below land surface measured on mo/day/yr 4 / 19 / 96  
 Pump test data: Well water was ft. after hours pumping gpm  
 Est. Yield 30+ gpm: Well water was ft. after hours pumping gpm  
 Bore Hole Diameter: 9 in. to 70 ft., and in. to ft.  
 WELL WATER TO BE USED AS:  
 1 Domestic 3 Feedlot 6 Oil field water supply 9 Dewatering 12 Other (Specify below)  
 2 Irrigation 4 Industrial 7 Lawn and garden only 10 Monitoring well  
 Was a chemical/bacteriological sample submitted to Department? Yes.....No.....\*.....; If yes, mo/day/yr sample was submitted  
 Water Well Disinfected? Yes \* No

5 TYPE OF BLANK CASING USED:  
 1 Steel 3 RMP (SR) 5 Wrought iron 8 Concrete tile CASING JOINTS: Glued .. \* .. Clamped ..  
 2 PVC 4 ABS 6 Asbestos-Cement 9 Other (specify below) Welded ..  
 7 Fiberglass Threaded ..  
 Blank casing diameter 5 in. to 70 ft., Dia in. to ft., Dia in. to ft.  
 Casing height above land surface 16 in., weight 160 lbs./ft. Wall thickness or gauge No. 214

TYPE OF SCREEN OR PERFORATION MATERIAL:  
 1 Steel 3 Stainless steel 5 Fiberglass 7 PVC 10 Asbestos-cement  
 2 Brass 4 Galvanized steel 6 Concrete tile 8 RMP (SR) 11 Other (specify)  
 9 ABS 12 None used (open hole)

SCREEN OR PERFORATION OPENINGS ARE:  
 1 Continuous slot 3 Mill slot 5 Gauzed wrapped 8 Saw cut 11 None (open hole)  
 2 Louvered shutter 4 Key punched 6 Wire wrapped 9 Drilled holes  
 7 Torch cut 10 Other (specify)

SCREEN-PERFORATED INTERVALS: From 50 ft. to 70 ft., From ft. to ft.  
 From ft. to ft., From ft. to ft.  
 GRAVEL PACK INTERVALS: From 27 ft. to 70 ft., From ft. to ft.  
 From ft. to ft., From ft. to ft.

6 GROUT MATERIAL: 1 Neat cement 2 Cement grout 3 Bentonite 4 Other  
 Grout Intervals: From 3 ft. to 27 ft., From ft. to ft., From ft. to ft.  
 What is the nearest source of possible contamination:  
 1 Septic tank 4 Lateral lines 7 Pit privy 10 Livestock pens 14 Abandoned water well  
 2 Sewer lines 5 Cess pool 8 Sewage lagoon 11 Fuel storage 15 Oil well/Gas well  
 3 Watertight sewer lines 6 Seepage pit 9 Feedyard 12 Fertilizer storage 16 Other (specify below)  
 13 Insecticide storage  
 Direction from well? WEST How many feet? 140

FROM	TO	LITHOLOGIC LOG	FROM	TO	PLUGGING INTERVALS
0	6	DARK TOP SOIL			
6	14	BROWN CLAY			
14	19	LITE COLOR SHALEY CLAY			
19	23	LITE COLOR LIMESTONE			
23	35	GRAY CLAY			
35	36	GRAY LIMESTONE			
36	41	GRAY SHALE & CLAY			
41	56	RED CLAY & SHALE			
56	58	GRAY SOFT CLAY			
58	66	HARD GRAY LIMESTONE			
66	70	HARD DARK SHALE			

7 CONTRACTOR'S OR LANDOWNER'S CERTIFICATION: This water well was (1) constructed, (2) reconstructed, or (3) plugged under my jurisdiction and was completed on (mo/day/year) 4 / 19 / 96 and this record is true to the best of my knowledge and belief. Kansas Water Well Contractor's License No. 397 This Water Well Record was completed on (mo/day/yr) 4 / 29 / 96 under the business name of CENTRAL KANSAS DRILLING by (signature) Harold D. Martin