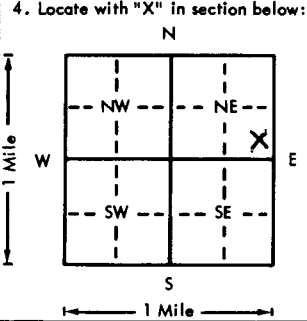
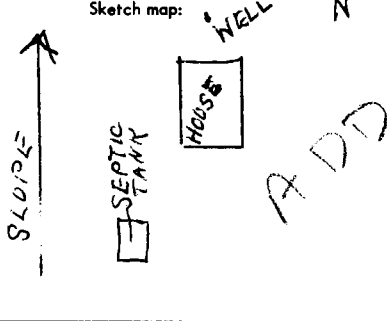


USE TYPEWRITER OR BALL  
POINT PEN—PRESS FIRMLY,  
PRINT CLEARLY.

WATER WELL RECORD  
KSA 82a-1201-1215

Kansas Department of Health and  
Environment—Division of Environment  
(Water well Contractors)  
Topeka, Kansas 66620

1. Location of well:	County <b>Dickinson</b>	Fraction <b>SE 1/4 SE 1/4 NE 1/4</b>	Section number <b>26</b>	Township number <b>T 12 S</b>	Range number <b>R 2 E</b>
2. Distance and direction from nearest town or city: <b>4 N, 2 1/2 E, 1/4 S</b> Street address of well location if in city: <b>Abilene</b>		3. Owner of well: <b>Duane Curran</b> R.R. or street: <b>R.R. 1</b> City, state, zip code: <b>Abilene, Kansas 67410</b>			
4. Locate with "X" in section below: 		Sketch map: 			
5. Type and color of material		From	To	6. Bore hole dia. <b>8</b> in. Completion date <b>1/17/76</b> Well depth <b>171</b> ft.	
Clay		0	12	7. <input checked="" type="checkbox"/> Cable tool <input checked="" type="checkbox"/> Rotary <input type="checkbox"/> Driven <input type="checkbox"/> Dug <input type="checkbox"/> Hollow rod <input type="checkbox"/> Jetted <input type="checkbox"/> Bored <input type="checkbox"/> Reverse rotary	
Buff clay and shaley rock		12	50	8. Use: <input checked="" type="checkbox"/> Domestic <input type="checkbox"/> Public supply <input type="checkbox"/> Industry <input type="checkbox"/> Irrigation <input type="checkbox"/> Air conditioning <input type="checkbox"/> Stock <input type="checkbox"/> Lawn <input type="checkbox"/> Oil field water <input type="checkbox"/> Other	
Rock		50	58	9. Casing: Material <b>PLST</b> Height: <b>Above</b> or below Threaded <input type="checkbox"/> Welded <input checked="" type="checkbox"/> Surface <b>18</b> in. RMP <input checked="" type="checkbox"/> PVC <input type="checkbox"/> Weight <b>18</b> lbs./ft. Dia. <b>5</b> in. to <b>171</b> ft. depth Wall Thickness: inches or Dia. <b>5</b> in. to <b>171</b> ft. depth gage No. <b>0.214</b>	
Gray shale		58	70	10. Screen: Manufacturer's name <b>Western PLASTICS</b> Type <b>RMP</b> Dia. <b>5</b> in. Slot/gauze <b>3/32</b> Length <b>81</b> in. Set between <b>90</b> ft. and <b>171</b> ft. Gravel pack? <b>Yes</b> Size range of material <b>1/8 to 1/4</b>	
White shale		70	76	11. Static water level: <b>90</b> ft. below land surface Date <b>1/17/76</b>	
Red shale		76	89	12. Pumping level below land surfaces: ____ ft. after ____ hrs. pumping ____ g.p.m. ____ ft. after ____ hrs. pumping ____ g.p.m. Estimated maximum yield <b>8</b> g.p.m.	
White shale		89	93	13. Water sample submitted: ____ mo./day/yr. Yes <input checked="" type="checkbox"/> No <input type="checkbox"/> Date ____	
Limestone		93	121	14. Well head completion: <input checked="" type="checkbox"/> Pitless adapter ____ inches above grade	
Granite		121	122	15. Well grouted? <b>Yes</b> With: <input checked="" type="checkbox"/> Neat cement <input type="checkbox"/> Bentonite <input type="checkbox"/> Concrete Depth: From <b>0</b> ft. to <b>10</b> ft.	
Limestone		122	124	16. Nearest source of possible contamination: <b>septic tank</b> ft. <b>100</b> Direction <b>south</b> Type <b>tank</b> Well disinfected upon completion? <input checked="" type="checkbox"/> Yes <input type="checkbox"/> No	
Red shale		124	127	17. Pump: Manufacturer's name <b>Rada</b> Nat installed Model number <b>9D9P051</b> HP <b>1</b> Volts <b>220</b> Length of drop pipe <b>150</b> ft. capacity <b>8</b> g.p.m. Type: <input checked="" type="checkbox"/> Submersible <input type="checkbox"/> Turbine <input type="checkbox"/> Jet <input type="checkbox"/> Reciprocating <input type="checkbox"/> Centrifugal <input type="checkbox"/> Other	
Gray shale		127	131	20. Water well contractor's certification: This well was drilled under my jurisdiction and this report is true to the best of my knowledge and belief. <b>Rader Drilling Co.</b> <b>194</b> Business name <b>Carlton, Kans.</b> License No. <b>67429</b> Address <b>Brent E Rader</b> Date <b>2-19-76</b> Signed <b>Brent E Rader</b> Authorized representative	
White shale		131	137		
Red shale		137	158		
Hard rock		158	171		
(Use a second sheet if needed)					
18. Elevation:	19. Remarks:		20. Water well contractor's certification:		
Topography: <input checked="" type="checkbox"/> Hill <input type="checkbox"/> Slope <input type="checkbox"/> Upland <input type="checkbox"/> Valley					

Forward the white, blue and pink copies to the Department of Health and Environment

Form WWC-5