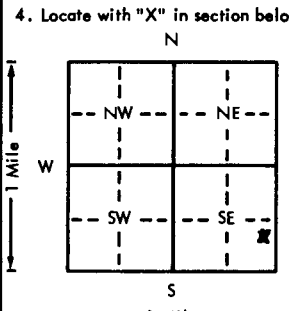
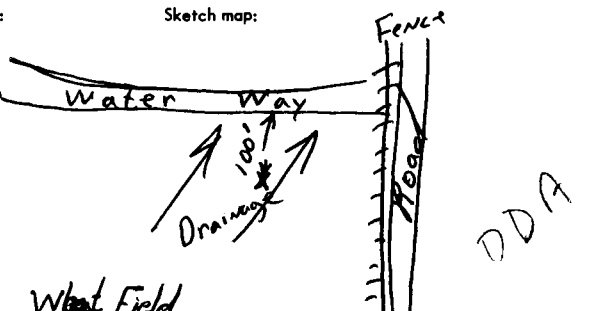


USE TYPEWRITER OR BALL POINT PEN-PRESS FIRMLY. PRINT CLEARLY.

WATER WELL RECORD
KSA 82a-1201-1215

Kansas Department of Health and Environment-Division of Environment (Water well Contractors)
Topeka, Kansas 66620

1. Location of well:	County Dickinson	Fraction NE 1/4 SE 1/4 SE 1/4	Section number 27	Township number T 12 S R 2	Range number EW
2. Distance and direction from nearest town or city: and 1 1/2 mile East of Abilene			3. Owner of well: Tom Whitehair R.R. or street: 1305 NW 2 City, state, zip code: Abilene, Kan		
4. Locate with "X" in section below: 			Sketch map: 		
5. Type and color of material			From	To	6. Bore hole dia. 6 1/4 in. Completion date 12-2-76 Well depth 80 ft.
Topsoil - Blk			0	3	7. <input checked="" type="checkbox"/> Cable tool <input type="checkbox"/> Rotary <input type="checkbox"/> Driven <input type="checkbox"/> Dug <input type="checkbox"/> Hollow rod <input type="checkbox"/> Jetted <input type="checkbox"/> Bored <input type="checkbox"/> Reverse rotary
Shale - Yel			3	7	8. Use: <input type="checkbox"/> Domestic <input type="checkbox"/> Public supply <input type="checkbox"/> Industry <input type="checkbox"/> Irrigation <input type="checkbox"/> Air conditioning <input checked="" type="checkbox"/> Stock <input type="checkbox"/> Lawn <input type="checkbox"/> Oil field water <input type="checkbox"/> Other
Lime Broken - Yel			7	10	9. Casing: Material PLS Height: Above or below Threaded <input type="checkbox"/> Welded glw Surface 24 in. RMP <input checked="" type="checkbox"/> PVC <input type="checkbox"/> Weight _____ lbs./ft. Dia. 5 in. to 55 ft. depth Well Thickness: inches or Dia. _____ in. to _____ ft. depth gage No. 1200
Shale - Yel			10	28	10. Screen: Manufacturer's name Sunflower Type RMP Dia. 5" Slot/gauze 1/8" Length 25' Set between 55 ft. and 80 ft. ft. and _____ ft. Gravel pack? NO Size range of material _____
Red Rock			28	34	11. Static water level: _____ mo./day/yr. 55 ft. below land surface Date 12-2-76
Shale - lite			34	37	12. Pumping level below land surfaces: _____ ft. after _____ hrs. pumping _____ g.p.m. _____ ft. after _____ hrs. pumping _____ g.p.m. Estimated maximum yield 13 g.p.m.
Lime - Yel			37	40	13. Water sample submitted: _____ mo./day/yr. Yes <input checked="" type="checkbox"/> No <input type="checkbox"/> Date _____
Shale - lite			40	45	14. Well head completion: <input type="checkbox"/> Pitless adapter 24 Inches above grade
Lime - Yel			55	62	15. Well grouted? Yes With: <input type="checkbox"/> Neat cement <input type="checkbox"/> Bentonite <input checked="" type="checkbox"/> Concrete Depth: From 0 ft. to 10 ft.
Shale - Blu			62	66	16. Nearest source of possible contamination: Water way ft. 100 Direction N Type Way Well disinfected upon completion? <input checked="" type="checkbox"/> Yes <input type="checkbox"/> No
Lime - Yel			66	69	17. Pump: <input checked="" type="checkbox"/> Not installed Manufacturer's name _____ Model number _____ HP _____ Volts _____ Length of drop pipe _____ ft. capacity _____ g.p.m. Type: <input type="checkbox"/> Submersible <input type="checkbox"/> Turbine <input type="checkbox"/> Jet <input type="checkbox"/> Reciprocating <input type="checkbox"/> Centrifugal <input type="checkbox"/> Other
Shale - Blu			69	71	20. Water well contractor's certification: This well was drilled under my jurisdiction and this report is true to the best of my knowledge and belief. Zinn Water Well Drilling 218 Business name _____ License No. _____ Address Lost Springs, Kan Signed Joseph A. Zinn Date 12-2-76 Authorized representative
Lime - wht			71	80	
Red Rock			80	80	
(Use a second sheet if needed)					
18. Elevation:	19. Remarks:		20. Water well contractor's certification:		
Topography: <input type="checkbox"/> Hill <input checked="" type="checkbox"/> Slope <input type="checkbox"/> Upland <input type="checkbox"/> Valley					

Forward the white, blue and pink copies to the Department of Health and Environment

Form WWC-5

12-27-76
R 27
S 12
E EW
SE SE
SE SE