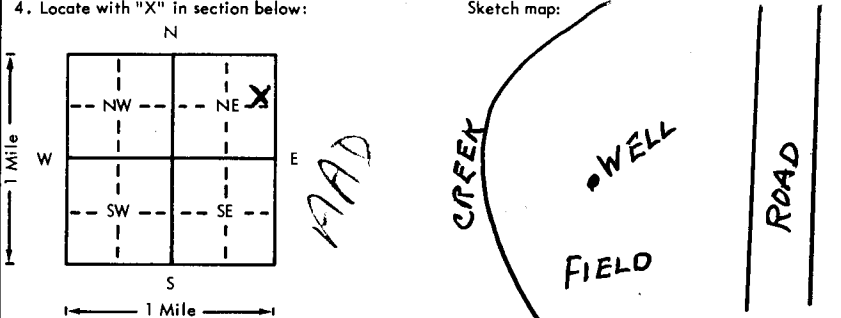


USE TYPEWRITER OR BALL
POINT PEN-PRESS FIRMLY,
PRINT CLEARLY.

WATER WELL RECORD
KSA 82a-1201-1215

Kansas Department of Health and
Environment-Division of Environment
(Water well Contractors)
Topeka, Kansas 66620

1. Location of well:		County Dickinson	Fraction SE 1/4 NE 1/4 NE 1/4	Section number 28	Township number T 12 S	Range number R 2 E
X Distance and direction from nearest town or city: 4 miles north of Abilene (correct)			3. Owner of well: Andy Linn R.R. or street: Abilene, Kansas City, state, zip code:			
4. Locate with "X" in section below: 			6. Bore hole dia. 8 in. Completion date 11/1/77 Well depth 62 ft.			
5. Type and color of material			7. <input type="checkbox"/> Cable tool <input checked="" type="checkbox"/> Rotary <input type="checkbox"/> Driven <input type="checkbox"/> Dug <input type="checkbox"/> Hollow rod <input type="checkbox"/> Jetted <input type="checkbox"/> Bored <input type="checkbox"/> Reverse rotary			
			8. Use: <input checked="" type="checkbox"/> Domestic <input type="checkbox"/> Public supply <input type="checkbox"/> Industry <input type="checkbox"/> Irrigation <input type="checkbox"/> Air conditioning <input type="checkbox"/> Stock <input type="checkbox"/> Lawn <input type="checkbox"/> Oil field water <input type="checkbox"/> Other			
			9. Casing: Material plst Height: Above or below XXXX Threading Welded gl Surface 18 in. RMP <input checked="" type="checkbox"/> PVC Weight 47 lbs./ft. Dia. 5 in. to 62 ft. depth Wall Thickness: inches or Dia. 5 in. to 62 ft. depth gage No. 0.258			
			10. Screen: Manufacturer's name Western Plastics Type RMP Dia. 5" Slot/gauze 3/32 Length 47 Set between 15 ft. and 62 ft. ft. and 62 ft. Gravel pack? Yes Size range of material 1/16 to 3/8			
			11. Static water level: 11 ft. below land surface Date 11/1/77 mo./day/yr.			
(Use a second sheet if needed)			12. Pumping level below land surfaces: ft. after 7 hrs. pumping 7 g.p.m. ft. after 7 hrs. pumping 7 g.p.m. Estimated maximum yield 7 g.p.m.			
			13. Water sample submitted: Yes <input checked="" type="checkbox"/> No <input type="checkbox"/> Date 11/1/77 mo./day/yr.			
			14. Well head completion: 18 inches above grade Pitless adapter 18			
			15. Well grouted? Yes With: <input checked="" type="checkbox"/> Neat cement <input type="checkbox"/> Bentonite <input type="checkbox"/> Concrete Depth: From 0 ft. to 10 ft.			
			16. Nearest source of possible contamination: ft. none Direction none Type none Well disinfected upon completion? <input checked="" type="checkbox"/> Yes <input type="checkbox"/> No			
18. Elevation: Topography: <input type="checkbox"/> Hill <input type="checkbox"/> Slope <input type="checkbox"/> Upland <input type="checkbox"/> Valley			17. Pump: <input checked="" type="checkbox"/> Not installed Manufacturer's name XXXX Model number XXXX HP XXXX Volts XXXX Length of drop pipe XXXX ft. capacity XXXX g.p.m. Type: <input type="checkbox"/> Submersible <input type="checkbox"/> Turbine <input type="checkbox"/> Jet <input type="checkbox"/> Reciprocating <input type="checkbox"/> Centrifugal <input type="checkbox"/> Other			
			20. Water well contractor's certification: This well was drilled under my jurisdiction and this report is true to the best of my knowledge and belief. Rader Drilling Co. 194 Business name License No. Address Carlton, Kansas Signed Bruce E Rader Date 11/1/77 Authorized representative			
			19. Remarks:			
			19. Remarks:			
			19. Remarks:			

Forward the white, blue and pink copies to the Department of Health and Environment

Form WWC-5