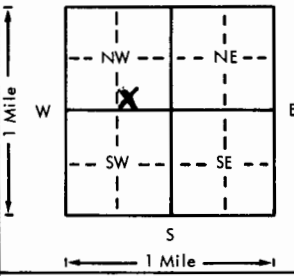
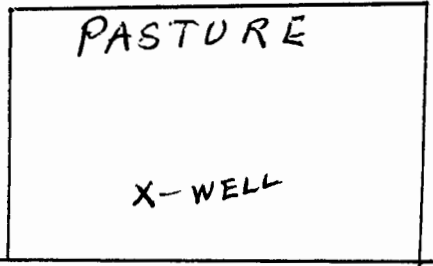


USE TYPEWRITER OR BALL  
POINT PEN-PRESS FIRMLY,  
PRINT CLEARLY.

WATER WELL RECORD  
KSA 82a-1201-1215

Kansas Department of Health and  
Environment-Division of Environment  
(Water well Contractors)  
Topeka, Kansas 66620

1. Location of well:	County <b>Dickinson</b>	Fraction <b>SW 1/4 SE 1/4 NW 1/4</b>	Section number <b>28</b>	Township number <b>T 12 S</b>	Range number <b>R 2 E/W</b>
<input checked="" type="checkbox"/> Distance and direction from nearest town or city: <b>3 1/2 miles north of Abilene</b>		3. Owner of well: <b>Vic Narciso, M.D.</b> R.R. or street: <b>501 Charles road</b> City, state, zip code: <b>Abilene, Kansas</b>			
4. Locate with "X" in section below: 		Sketch map: 		6. Bore hole dia. <b>8</b> in. Completion date <b>4/21/78</b> Well depth <b>53</b> ft.	
5. Type and color of material		From	To	7. <input checked="" type="checkbox"/> Cable tool <input checked="" type="checkbox"/> Rotary <input type="checkbox"/> Driven <input type="checkbox"/> Dug <input type="checkbox"/> Hollow rod <input type="checkbox"/> Jetted <input type="checkbox"/> Bored <input type="checkbox"/> Reverse rotary	
				8. Use: <input checked="" type="checkbox"/> Domestic <input type="checkbox"/> Public supply <input type="checkbox"/> Industry <input type="checkbox"/> Irrigation <input type="checkbox"/> Air conditioning <input type="checkbox"/> Stock <input type="checkbox"/> Lawn <input type="checkbox"/> Oil field water <input type="checkbox"/> Other	
				9. Casing: Material <b>Plat</b> Height: Above or below Threaded <input type="checkbox"/> Welded <b>g1</b> Surface <b>18</b> in. RMP <input checked="" type="checkbox"/> PVC <input type="checkbox"/> Weight <input type="checkbox"/> lbs./ft. Dia. <b>5</b> in. to <b>53</b> ft. depth Wall Thickness: <input type="checkbox"/> inches or Dia. <input type="checkbox"/> in. to <input type="checkbox"/> ft. depth gage No. <b>0.258</b>	
				10. Screen: Manufacturer's name <b>Western Plastics</b> Type <b>RMP</b> Dia. <b>5 1/2</b> Slot/gauze <b>3/32</b> Length <b>20</b> Set between <b>33</b> ft. and <b>53</b> ft. Gravel pack? <b>Yes</b> Size range of material <b>1/16 to 3/8</b>	
				11. Static water level: <input type="checkbox"/> mo./day/yr. <b>39</b> ft. below land surface Date <b>4/21/78</b>	
				12. Pumping level below land surfaces: ____ ft. after ____ hrs. pumping ____ g.p.m. ____ ft. after ____ hrs. pumping ____ g.p.m. Estimated maximum yield <b>24 1/2</b> g.p.m.	
				13. Water sample submitted: ____ mo./day/yr. <input type="checkbox"/> Yes <input checked="" type="checkbox"/> No Date ____	
				14. Well head completion: <input type="checkbox"/> Pitless adapter <b>18</b> inches above grade	
				15. Well grouted? <b>Yes</b> With: <input checked="" type="checkbox"/> Neat cement <input type="checkbox"/> Bentonite <input type="checkbox"/> Concrete Depth: From <b>0</b> ft. to <b>10</b> ft.	
				16. Nearest source of possible contamination: ft. ____ Direction ____ Type <b>ROSE</b> Well disinfected upon completion? <input checked="" type="checkbox"/> Yes <input type="checkbox"/> No	
				17. Pump: <input checked="" type="checkbox"/> Not installed Manufacturer's name ____ Model number ____ HP ____ Volts ____ Length of drop pipe ____ ft. capacity ____ g.p.m. Type: <input type="checkbox"/> Submersible <input type="checkbox"/> Turbine <input type="checkbox"/> Jet <input type="checkbox"/> Reciprocating <input type="checkbox"/> Centrifugal <input type="checkbox"/> Other	
				20. Water well contractor's certification: This well was drilled under my jurisdiction and this report is true to the best of my knowledge and belief. <b>Rader Drilling Co.</b> 194 Business name License No. <b>67429</b> Address <b>Carlton, Kansas</b> Signed <b>Brent E. Rader</b> Date <b>8-10-78</b> Authorized representative	
18. Elevation:	19. Remarks:  Topography: <input checked="" type="checkbox"/> Hill <input type="checkbox"/> Slope <input type="checkbox"/> Upland <input type="checkbox"/> Valley				

Forward the white, blue and pink copies to the Department of Health and Environment

Form WWC-5