


1 LOCATION OF WATER WELL: County: Dickinson Fraction: NW 1/4 Sec 34 SW 1/4 Section Number: 34 Township Number: T 12 S Range Number: R 2 E

Distance and direction from nearest town or city street address of well if located within city?
2 N 34 E Abilene

2 WATER WELL OWNER: Kirk Whitehair
 RR#, St. Address, Box #: RR 3-
 City, State, ZIP Code: Abilene, KS. 67460
 Board of Agriculture, Division of Water Resources
 Application Number:

3 LOCATE WELL'S LOCATION WITH AN "X" IN SECTION BOX:

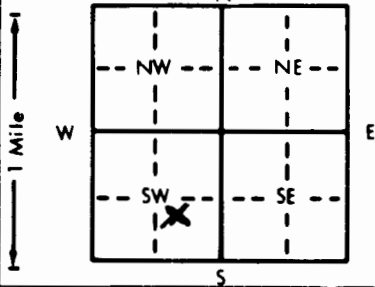

4 DEPTH OF COMPLETED WELL: 84 ft. ELEVATION: ft.
 Depth(s) Groundwater Encountered 39 ft. 2. ft. 3. ft.
 WELL'S STATIC WATER LEVEL 39 ft. below land surface measured on mo/day/yr 3-16-92
 Pump test data: Well water was ft. after hours pumping gpm
 Est. Yield 10-12 gpm Well water was ft. after hours pumping gpm
 Bore Hole Diameter: 8 1/2 in. to 8 1/4 in. to ft., and in. to ft.
 WELL WATER TO BE USED AS:
 1 Domestic 3 Feedlot 6 Oil field water supply 9 Dewatering 12 Other (Specify below)
 2 Irrigation 4 Industrial 7 Lawn and garden only 10 Monitoring well
 Was a chemical/bacteriological sample submitted to Department? Yes No X; If yes, mo/day/yr sample was submitted
 Water Well Disinfected? Yes X No

5 TYPE OF BLANK CASING USED:
 1 Steel 3 RMP (SR) 5 Wrought iron 8 Concrete tile CASING JOINTS: Glued X Clamped
 2 PVC 4 ABS 6 Asbestos-Cement 9 Other (specify below) Welded
 7 Fiberglass Threaded
 Blank casing diameter 5 in. to 6 1/4 ft. Dia. in. to ft. Dia. in. to ft.
 Casing height above land surface 12 in. weight CLASS 160 lbs./ft. Wall thickness or gauge No. 2 1/4

TYPE OF SCREEN OR PERFORATION MATERIAL:
 1 Steel 3 Stainless steel 5 Fiberglass 7 PVC 10 Asbestos-cement
 2 Brass 4 Galvanized steel 6 Concrete tile 8 RMP (SR) 11 Other (specify)
 9 ABS 12 None used (open hole)

SCREEN OR PERFORATION OPENINGS ARE:
 1 Continuous slot 3 Mill slot 5 Gauzed wrapped 8 Saw cut 11 None (open hole)
 2 Louvered shutter 4 Key punched 6 Wire wrapped 9 Drilled holes
 7 Torch cut 2 1/4 10 Other (specify)

SCREEN-PERFORATED INTERVALS: From 64 ft. to 84 ft. From ft. to ft.
 From ft. to ft. From ft. to ft.
 GRAVEL PACK INTERVALS: From 23 ft. to 84 ft. From ft. to ft.
 From ft. to ft. From ft. to ft.

6 GROUT MATERIAL: 1 Neat cement 2 Cement grout 3 Bentonite 4 Other
 Grout Intervals: From 0 ft. to 23 ft. From ft. to ft. From ft. to ft.

What is the nearest source of possible contamination:
 1 Septic tank 4 Lateral lines 7 Pit privy 10 Livestock pens 14 Abandoned water well
 2 Sewer lines 5 Cess pool 8 Sewage lagoon 11 Fuel storage 15 Oil well/Gas well
 3 Watertight sewer lines 6 Seepage pit 9 Feedyard 12 Fertilizer storage 16 Other (specify below)
 13 Insecticide storage
 Direction from well? W How many feet? 200'

FROM	TO	LITHOLOGIC LOG	FROM	TO	PLUGGING INTERVALS
<u>0</u>	<u>8</u>	<u>Yellow Clay</u>			
<u>8</u>	<u>15</u>	<u>Red Shale</u>			
<u>15</u>	<u>47</u>	<u>Yellow + Red Clay</u>			
<u>47</u>	<u>64</u>	<u>Blue Shale</u>			
<u>64</u>	<u>65</u>	<u>Water</u>			
<u>65</u>	<u>84</u>	<u>Blue + Gray Shale</u>			

7 CONTRACTOR'S OR LANDOWNER'S CERTIFICATION: This water well was (1) constructed, (2) reconstructed, or (3) plugged under my jurisdiction and was completed on (mo/day/year) 3-16-92 and this record is true to the best of my knowledge and belief. Kansas Water Well Contractor's License No. 120 This Water Well Record was completed on (mo/day/yr) 3-17-92 under the business name of Backhus Drilling by (signature) Paul H. Backhus