

95.18779

39.001410

WATER WELL RECORD

Form WWC-5

KSA 82a-9212

1 LOCATION OF WATER WELL:	Fraction	Section Number	Township Number	Range Number
County: <u>Neosho</u>	<u>SE 1/4 SE 1/4 SE 1/4</u>	<u>16</u>	T <u>12</u> S	R <u>20</u> <u>EW</u>

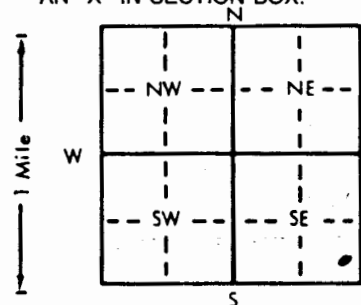
Distance and direction from nearest town or city street address of well if located within city?

3 miles NE of Lawrence2 WATER WELL OWNER: Joe. ReyesRR#, St. Address, Box #: R.R. 3City, State, ZIP Code: Lawrence, Mo. 66044

Board of Agriculture, Division of Water Resources

Application Number:

3 LOCATE WELL'S LOCATION WITH AN "X" IN SECTION BOX:

4 DEPTH OF COMPLETED WELL: 132 ft. ELEVATION:Depth(s) Groundwater Encountered 1 98-132 ft. 2. ft. 3. ft.WELL'S STATIC WATER LEVEL 50 ft. below land surface measured on mo/day/yr 8-1-84

Pump test data: Well water was ft. after hours pumping gpm

Est. Yield 12 gpm: Well water was ft. after hours pumping gpmBore Hole Diameter 6 1/2 in. to 132 ft., and in. to ft.

WELL WATER TO BE USED AS: 5 Public water supply 8 Air conditioning 11 Injection well

1 Domestic 3 Feedlot 6 Oil field water supply 9 Dewatering 12 Other (Specify below)

2 Irrigation 4 Industrial 7 Lawn and garden only 10 Observation well

Was a chemical/bacteriological sample submitted to Department? Yes No X; If yes, mo/day/yr sample was submittedWater Well Disinfected? Yes X No

5 TYPE OF BLANK CASING USED:

5 Wrought iron

8 Concrete tile

CASING JOINTS: Glued X Clamped

1 Steel

3 RMP (SR)

6 Asbestos-Cement

9 Other (specify below)

Welded

2 PVC

4 ABS

7 Fiberglass

Threaded

Blank casing diameter 5 in. to 132 ft., Dia in. to ft., Dia in. to ft.Casing height above land surface 18 in., weight lbs./ft. Wall thickness or gauge No.

TYPE OF SCREEN OR PERFORATION MATERIAL:

1 Steel

3 Stainless steel

5 Fiberglass

7 PVC

10 Asbestos-cement

2 Brass

4 Galvanized steel

6 Concrete tile

8 RMP (SR)

11 Other (specify)

9 ABS

12 None used (open hole)

SCREEN OR PERFORATION OPENINGS ARE:

1 Continuous slot

3 Mill slot

5 Gauzed wrapped

8 Saw cut

11 None (open hole)

2 Louvered shutter

4 Key punched

6 Wire wrapped

9 Drilled holes

7 Torch cut

10 Other (specify)

SCREEN-PERFORATED INTERVALS: From 112 ft. to 132 ft., From ft. to ft.

From ft. to ft., From ft. to ft.

GRAVEL PACK INTERVALS: From ft. to ft., From ft. to ft.

From ft. to ft., From ft. to ft.

6 GROUT MATERIAL:

1 Neat cement

2 Cement grout

3 Bentonite

4 Other

Grout Intervals: From 15 ft. to 34 ft. top ft., From ft. to ft., From ft. to ft.

What is the nearest source of possible contamination:

1 Septic tank

4 Lateral lines

7 Pit privy

10 Livestock pens

14 Abandoned water well

2 Sewer lines

5 Cess pool

8 Sewage lagoon

11 Fuel storage

15 Oil well/Gas well

3 Watertight sewer lines

6 Seepage pit

9 Feedyard

12 Fertilizer storage

16 Other (specify below)

13 Insecticide storage

Direction from well? EastHow many feet? 200

FROM	TO	LITHOLOGIC LOG	FROM	TO	LITHOLOGIC LOG
2	3	Top soil			
3	45.01	Yellow clay			
45	46.19	Blue shale			
46	98	Brown sand rock			
98	120	Gray sand rock			
120	132.23	White sand rock			
		T. P. 132.			

RECEIVED

AUG 20 1984

BUREAU OF OIL FIELD & ENVIRONMENTAL GEOLOGY

7 CONTRACTOR'S OR LANDOWNER'S CERTIFICATION: This water well was (1) constructed, (2) reconstructed, or (3) plugged under my jurisdiction and was completed on (mo/day/year) and this record is true to the best of my knowledge and belief. Kansas

Water Well Contractor's License No. 2-12 This Water Well Record was completed on (mo/day/yr) 8-14-84under the business name of Kenneth Schuch by (signature) Kenneth Schuch

INSTRUCTIONS: Use typewriter or ball point pen, PLEASE PRESS FIRMLY and PRINT clearly. Please fill in blanks, underline or circle the correct answers. Send top three copies to Kansas Department of Health and Environment, Division of Environment, Environmental Geology Section, Topeka, KS 66620. Send one to WATER WELL OWNER and retain one for your records.