


C SE NW

1. Location of well: County Douglas Fraction SE 1/4 NW 1/4 NE 1/4 Section number 29 Township number T 12 Range number S R 20 EW

2. Distance and direction from nearest town or city: Street address of well location if in city: 9th + Maple, Lawrence
3. Owner of well: FMC Corporation
R.R. or street: 9th + Maple St
City, state, zip code: Lawrence, Kansas 66044

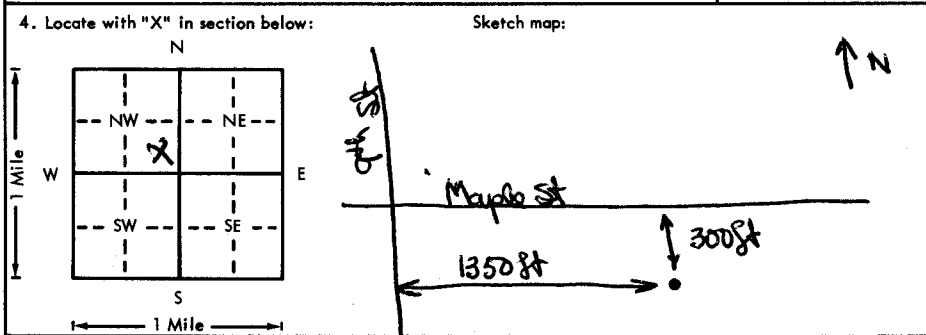

6. Bore hole dia. 8 in. Completion date 2/8/76
Well depth 36 ft.
7. Cable tool Rotary Driven Dug
 Hollow rod Jetted Bored Reverse rotary
8. Use: Domestic Public supply Industry
 Irrigation Air conditioning Stock
 Lawn Oil field water Other
9. Casing: Material Steel Height: Above or below
Threaded Welded Surface 2.24 ft in.
RMP PVC Weight lbs./ft.
Dia. 4 in. to 33 ft. depth; Wall Thickness: (inches) or
Dia. in. to ft. depth; gage No. 25

5. Type and color of material	From	To
<u>TOPSOIL</u>	<u>0</u>	<u>2</u>
<u>CLAY - brown</u>	<u>2</u>	<u>8</u>
<u>SAND - fine, brown</u>	<u>8</u>	<u>10</u>
<u>SANDY CLAY - brown</u>	<u>10</u>	<u>18</u>
<u>SAND - medium, gray</u>	<u>18</u>	<u>26</u>
<u>SAND - medium, gray</u>	<u>26</u>	<u>34</u>
<u>CLAY - gray</u>	<u>34</u>	<u>36</u>
(Use a second sheet if needed)		

10. Screen: Manufacturer's name Johnson
Type low carbon steel Dia. 4 in
30 gauge Length 3 ft
Set between 33 ft. and 36 ft.
ft. and ft.
Gravel pack? NO Size range of material
11. Static water level: mg./day/yr.
19 ft. below land surface Date 2/2/76
12. Pumping level below land surfaces: NA
 ft. after hrs. pumping g.p.m.
 ft. after hrs. pumping g.p.m.
Estimated maximum yield g.p.m.
13. Water sample submitted: mo./day/yr.
 Yes No Date
14. Well head completion: NA
 Pitless adapter inches above grade
15. Well grouted? YES
With: Neat cement Bentonite Concrete
Depth: From 0 ft. to 15 ft.
16. Nearest source of possible contamination: NA
ft. Direction Type
Well disinfected upon completion? Yes No
17. Pump: Not installed
Manufacturer's name
Model number HP Volts
Length of drop pipe ft. capacity g.p.m.
Type:
 Submersible Turbine
 Jet Reciprocating
 Centrifugal Other

18. Elevation: Topography: Hill Slope Upland Valley
19. Remarks:

20. Water well contractor's certification:
This well was drilled under my jurisdiction and this report is true to the best of my knowledge and belief.
JURMAN Bros 119A
Business name License No.
Address GARDENDALE HS
Signed James J. Jurman Date 2-2-76
Authorized representative

L 22 207 29 C SE NW 1/4 1/4