


95.21648 38.97702 130

1. Location of well: County Douglas Fraction C NE SW
NE 1/4 SW 1/4 SE 1/4 Section number 29 Township number T 12 Range number S R 20 EW

2. Distance and direction from nearest town or city:
Street address of well location if in city: 9th & Maple, Lawrence

3. Owner of well: FMC Corp.
R.R. or street: 9th & Maple
City, state, zip code: Lawrence, Mo 66044

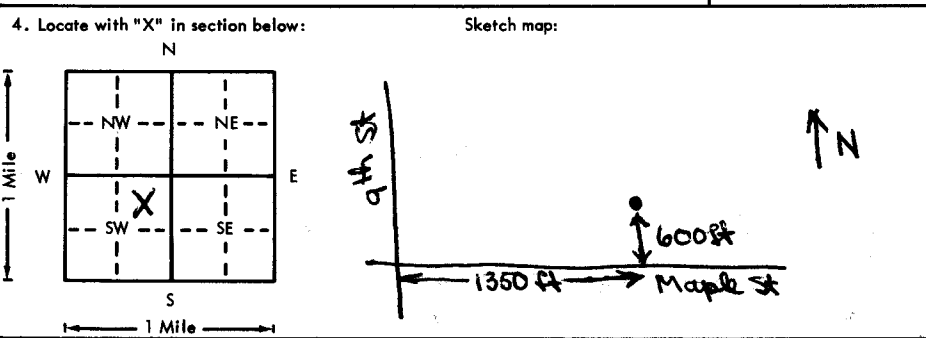

6. Bore hole dia. 5 in. Completion date 12/11/75
Well depth 45 ft.

7. Cable tool Rotary Driven Dug
 Hollow rod Jetted Bored Reverse rotary

8. Use: Domestic Public supply Industry
 Irrigation Air conditioning Stock
 Lawn Oil field water Other

9. Casing: Material Steel Height: Above or below
Threaded Welded Surface 4 1/2 in.
RMP PVC Weight lbs./ft.
Dia. 4 in. to 4 1/2 ft. depth Wall Thickness: 30 inches or
Dia. in. to ft. depth Gage No. 20.75

5. Type and color of material

	From	To
Fill	0	13
Sand, fine, white	13	19 1/2
Silty Sand, fine, brownish gray	19 1/2	21
Sand, fine, white fine, brownish gray	21	28
Sand, medium, fine, white red brown	28	32
Sand, medium, brownish gray	32	35 1/2
Clay, black	35 1/2	36 1/2
Sand, medium to coarse, brownish gray	36 1/2	51 1/2
Bedrock	51 1/2	

10. Screen: Manufacturer's name LEP
Johnson
Type l.c. steel Dia. 4 1/2
Slot/gauze 30 Length 3 1/2
Set between 42 ft. and 45 ft.
Gravel pack? Size range of material _____

11. Static water level: _____ mo./day/yr.
20 ft. below land surface. Date 12/11/75

12. Pumping level below land surfaces: NA
_____ ft. after _____ hrs. pumping _____ g.p.m.
_____ ft. after _____ hrs. pumping _____ g.p.m.
Estimated maximum yield _____ g.p.m.

13. Water sample submitted: _____ mo./day/yr.
Yes No Date _____

14. Well head completion: NA
 Pitless adapter 12" inches above grade

15. Well grouted? Yes
With: Neat cement Bentonite Concrete
Depth: From 0 ft. to 15 ft.

16. Nearest source of possible contamination: NA
ft. _____ Direction _____ Type _____
Well disinfected upon completion? Yes No

17. Pump: Not installed
Manufacturer's name _____
Model number _____ HP _____ Volts _____
Length of drop pipe _____ ft. capacity _____ g.p.m.
Type:
 Submersible Turbine
 Jet Reciprocating
 Centrifugal Other

18. Elevation: _____

19. Remarks: _____

Topography:
 Hill
 Slope
 Upland
 Valley

20. Water well contractor's certification:
This well was drilled under my jurisdiction and this report is true to the best of my knowledge and belief.
JUNGMAN BAS 119 A
Business name _____ License No. _____
Address CARBONDALE
Signed [Signature] Date 12-11-75
Authorized representative

12 20 W 29 2 NE SW 1/4 1/4 1/4