


95.21532 38.97792 134

1. Location of well: County Douglas Fraction NE 1/4 SW 1/4 Section number 29 Township number T 12 Range number S R 20 EW

2. Distance and direction from nearest town or city: Street address of well location if in city: 9th + Maple, Lawrence

3. Owner of well: FMC Corporation
R.R. or street: 9th + Maple
City, state, zip code: Lawrence, Kansas 66044

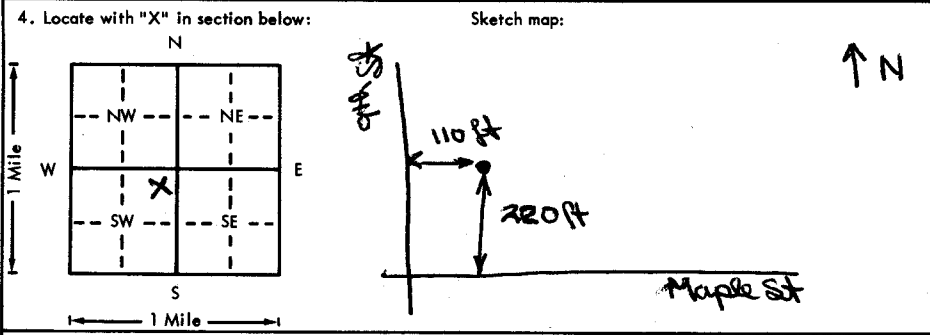

6. Bore hole dia. 8 in. Completion date 1/20/76
Well depth 47 ft.

7. Cable tool Rotary Driven Dug
 Hollow rod Jetted Bored Reverse rotary

8. Use: Domestic Public supply Industry
 Irrigation Air conditioning Stock
 Lawn Oil field water Other

9. Casing: Material Steel Height: above or below
Threaded Welded Surface 132 ft in.
RMP: PVC Weight lbs./ft.
Dia. 4 in. to 44 ft. depth Wall Thickness inches or
Dia. in. to ft. depth gage No. 235

5. Type and color of material	From	To
TOPSOIL	0	6
SILT SAND - fine, yellowish brown	6	14
SAND - fine, yellowish brown	14	20
SILT SAND - fine, yellowish brown	20	24
SAND - medium, yellowish brown	24	31
SAND - medium, grayish brown	31	32
SAND - coarse, yellowish brown	32	33
SAND - medium to coarse, grayish brown	33	39
SAND - coarse, gray	39	49
SILT - gray	49	50.5
SAND - medium, coarse	50.5	52
BEDROCK	52	

10. Screen: Manufacturer's name Schman
Type low carbon steel Dia. 4 in
30 / gauge 30 Length 38
Set between 44 ft. and 47 ft.
 ft. and ft.
Gravel pack? NO Size range of material

11. Static water level: 22 ft. below land surface Date 1/20/76 mo./day/yr.

12. Pumping level below land surfaces: NA
 ft. after hrs. pumping g.p.m.
 ft. after hrs. pumping g.p.m.
Estimated maximum yield g.p.m.

13. Water sample submitted: mo./day/yr.
Yes No Date

14. Well head completion: NA
 Pitless adapter 127 Inches above grade

15. Well grouted? YES
With: Near cement Bentonite Concrete
Depth: From 0 ft. to 15 ft.

16. Nearest source of possible contamination: NA
ft. Direction Type
Well disinfected upon completion? Yes No

17. Pump: Not installed
Manufacturer's name
Model number HP Volts
Length of drop pipe ft. capacity g.p.m.
Type:
 Submersible Turbine
 Jet Reciprocating
 Centrifugal Other

18. Elevation: Topography: Hill Slope Upland Valley

19. Remarks: (Use a second sheet if needed)

20. Water well contractor's certification: This well was drilled under my jurisdiction and this report is true to the best of my knowledge and belief.

JUNEMAN BROS 119A
Business name License No.
Address CARDONDALE KS.
Signed [Signature] Date 1-20-76
Authorized representative

L
2
2
0
W
2
9
S
1
4
1
4
1
4
NE
NE
SW